



**Project: Renovate Building 28 First Floor East RRTP**  
**Revision Set: 2 (Prebid Addendum)**

VA Project #: 656-19-306  
Anderson Project # 15451

Issued to: **St Cloud V. A. Health Care System**  
4801 Veterans Dr, St Cloud, MN 56303  
Attn: Mike Engmark, COR

Date: July 23rd, 2021

**DRAWING SHEET(S)**

**REPLACE:** *(The drawing sheet(s) below replace previously issued versions)*

Sheet MP101, Basement Piping Plan: Clarified notes to indicate deduct alternate #4.

Sheet MP111, First Floor Piping Plan: Added 3 temperature monitors for refrigerators.

Sheet M602, Mechanical/Electrical Schedules: Clarified Fluid Cooler omitted under deduct alternate #4.

Sheet M603, Mechanical/Electrical Schedules: Updated VFD equipment schedule.

Sheet EP111, First Power Floor Plan: Revised device layout in patient rooms.

Sheet ES111, First Systems Floor Plan: Revised device layout in patient rooms.

**ATTACHMENTS:**

**DRAWING SHEETS** *(30"x42" when printed at full size)*

- SHEET MP101 (Revision Set 2- Prebid Addendum, Dated 7/23/2021)
- SHEET MP111 (Revision Set 2- Prebid Addendum, Dated 7/23/2021)
- SHEET M602 (Revision Set 2- Prebid Addendum, Dated 7/23/2021)
- SHEET M603 (Revision Set 2- Prebid Addendum, Dated 7/23/2021)
- SHEET EP111 (Revision Set 2- Prebid Addendum, Dated 7/23/2021)
- SHEET ES111 (Revision Set 2- Prebid Addendum, Dated 7/23/2021)

**Revision Document issued by:**

Steve Schlotthauer, Anderson Engineering

-End of document-



**GENERAL NOTES:**

- A. MECHANICAL CONTRACTOR WILL BE RESPONSIBLE TO REVIEW ACCESSIBILITY TO AREAS OUTSIDE THE CONSTRUCTION LIMITS TO DETERMINE APPROXIMATE AMOUNT OF OVERTIME REQUIRED TO PERFORM ALL MECHANICAL WORK INDICATED. COORDINATION OF SCHEDULES WITH ADJACENT DEPARTMENTS AND CLEANING OF ALL DEBRIS AFTER EACH WORK SHIFT SHOULD BE ASSUMED IN THE BASE BID SCOPE.
- B. ANY MAJOR OUTAGES INDICATED ON THESE DRAWINGS SHALL BE SCHEDULED TO BE PERFORMED AFTER NORMAL BUSINESS HOURS OR DURING WEEKEND PERIODS TO MINIMIZE DISRUPTION.
- C. COORDINATE ALL NEW PIPE ROUTING WITH ALL OTHER TRADES TO ENSURE ADEQUATE CLEARANCES FOR DUCTWORK, ELECTRICAL CONDUIT, STRUCTURAL SUPPORTS, PIPING, ETC. ANY UNAVOIDABLE CONFLICTS SHALL BE BROUGHT TO THE ATTENTION OF THE ARCHITECT/ENGINEER OF RECORD. PROVIDE ALL OFFSETS AND TRANSITIONS AS REQUIRED FOR A CLEAN INSTALLATION.
- D. SUPPORT ALL PIPING DIRECTLY TO STRUCTURE. DO NOT SUPPORT ANY PIPING FROM DUCTWORK, CONDUIT, OR OTHER PIPING ENCOUNTERED.
- E. WHERE MECHANICAL SYSTEMS TO REMAIN ARE DAMAGED, OR DISTURBED, DURING THE COURSE OF CONSTRUCTION THE CONTRACTOR WILL BE RESPONSIBLE TO REPAIR DAMAGED PORTIONS AND INSTALL NEW PRODUCTS OF EQUAL QUALITY AND FUNCTIONALITY.
- F. ALL EXISTING PIPING THROUGH NEW FIRE RATED WALLS SHALL BE ADEQUATELY FIRE SEALED AS REQUIRED.
- G. THE MECHANICAL CONTRACTOR SHALL MAINTAIN ACCURATE RECORD DRAWINGS SHOWING ALL DISCREPANCIES WITH ANY EXISTING PIPING INDICATED OR REVISIONS TO THE NEW PIPING LAYOUTS. ALL CHANGES WILL BE UPDATED WITHIN THE FINAL RECORD DRAWING SET.
- H. THE SMALLEST ALLOWABLE PIPE SIZE FOR HEATING WATER SUPPLY AND RETURN WILL BE 3/4".
- I. UNLESS NOTED OTHERWISE, HEATING WATER SUPPLY AND RETURN PIPING TAKE-OFFS TO REHEAT COILS SHALL BE 3/4" DIAMETER.
- J. HEATING WATER SUPPLY AND RETURN PIPING TAKE-OFFS SHALL BE OFF THE TOP OF MAIN.
- K. PROVIDE 1/2" DRAIN VALVE AT NEW HEATING WATER SUPPLY AND RETURN PIPE LOW POINTS, DOWNSTREAM OF ISOLATION VALVES.
- L. ALL VALVES TO BE LOCATED ABOVE LAY-IN CEILING FOR ACCESSIBILITY. WHERE VALVES MUST BE LOCATED ABOVE GYPSUM BOARD CEILINGS, MECHANICAL CONTRACTOR SHALL COORDINATE LOCATIONS OF 2'x2' ACCESS PANELS WITH GENERAL CONTRACTOR.

**KEY NOTES:**

- 1. CHILLED WATER SUPPLY AND RETURN PIPING BURIED BENEATH GRADE. REFER TO SPECIFICATION REQUIREMENTS ON THIS DRAWING FOR STEEL PIPING CASED WITHIN HDPE FOR UNDERGROUND INSTALLATION. CONTRACTOR TO EITHER BURY PIPE UNDER FROST LINE OR COVER WITH 2" FIBERBOARD INSULATION TO PROTECT PER DETAIL (PROVIDED UPON REQUEST TO NOT BURY UNDER FROST LEVEL).
- 2. PROVIDE DOUBLE OFFSET HIGH PERFORMANCE BUTTERFLY VALVES WITH WEATHER RESISTANT GEAR DRIVEN ACTUATOR, BRAY VALVE OR MANUAL/OK OR EQUAL. INSTALL VALVES ON BOTH CHILLER CONNECTIONS WITHIN FENCE ENCLOSURE.
- 3. INSTALL FLOW SWITCH FURNISHED BY CHILLER MANUFACTURER. COORDINATE INTEGRATION WITH PACKAGED CHILLER CONTROLLER AND BUILDING AUTOMATION. SEE SEQUENCE OF OPERATION.
- 4. REFER TO ARCHITECTURAL PLAN FOR CHASE WALLS AROUND CHILLED WATER PIPING DROPS. SAWCUT FLOOR IF REQUIRED AND EXCAVATE TO PENETRATE WALL APPROXIMATELY 48" BELOW GRADE (COORDINATE WITH EXISTING WALL FOOTINGS). PENETRATE WALL USING LINKSEAL ASSEMBLIES AND INFILL WITH DRAINABLE FILL MATERIAL ON COMPLETION PRIOR TO PATCHING FLOOR TO ORIGINAL CONDITION.
- 5. CORE DRILL FOUNDATION WALL PENETRATIONS FOR CHILLED WATER PIPING A MINIMUM OF 48" BELOW GRADE (OR PROVIDE INSULATION REQUIREMENTS FROM KEY NOTE #1 ABOVE). INSTALL LINKSEAL ASSEMBLY AT WALL PENETRATIONS TO SEAL WATER TIGHT.
- 6. UNDER ACCEPTANCE OF DEDUCT ALTERNATE #4 THE INDICATED DRYCOOLER, AND ASSOCIATED PIPING AND CONTROLS, WILL NOT BE INSTALLED. INSTEAD EXISTING CONDENSING UNIT AND CHILLER WILL REMAIN. THE CHILLER SUPPLY/RETURN WATER CONNECTIONS INTO NEW ISOLATION VALVES INDICATED. COORDINATE ALL PIPING INSTALLATION TO ALLOW FOR MINIMAL OUTAGE TO THIS SYSTEM THAT PROVIDES YEAR-ROUND COOLING TO LOWER LEVEL.
- 7. PROVIDE DRYCOOLER ON EXISTING CONCRETE PAD. CONTRACTOR TO VERIFY PAD SIZE WITH SHOP DRAWINGS AND EXTEND, OR MODIFY, CONCRETE PAD AS REQUIRED FOR DIMENSIONS OF DRYCOOLER FURNISHED WITHIN THEIR CONTRACT. DO NOT PROVIDE UNDER ACCEPTANCE OF DEDUCT ALTERNATE #4.
- 8. ROUTE 4" PIPING UNDERGROUND WITHIN CASED PIPING SYSTEM (REFER TO SPECIFICATION REQUIREMENTS ON THIS DRAWING). CONTRACTOR TO PROVIDE MINIMUM OF 48" BURY ABOVE PIPING AND TERMINATE UP THROUGH GROUND NEAR EXISTING EQUIPMENT PAD.
- 9. PROVIDE LOW POINT DRAIN WITH THREADED CONNECTION (TYPICAL OF ALL LOW SPOTS WITHIN CHILLED WATER SYSTEM FOR COMPLETE DRAINAGE WHEN REQUIRED).
- 10. PIPING SHOWN IN THIS AREA IS WITHIN CONFINED SPACE. STEAM TUNNEL UNDER WALKWAY ABOVE IS VERY CONGESTED AND SHOULD BE REVIEWED PRIOR TO BID.
- 11. PROVIDE 2-WAY CONTROL VALVE TO AUTOMATICALLY ISOLATE LOWER LEVEL CHILLER, OR FLUID COOLER (UNDER ALTERNATE) FROM REMAINDER OF CENTRAL SYSTEM FOR COOLING LOWER LEVEL DURING WINTER MONTHS. REFER TO SEQUENCE OF OPERATION.

**KEY PLAN**

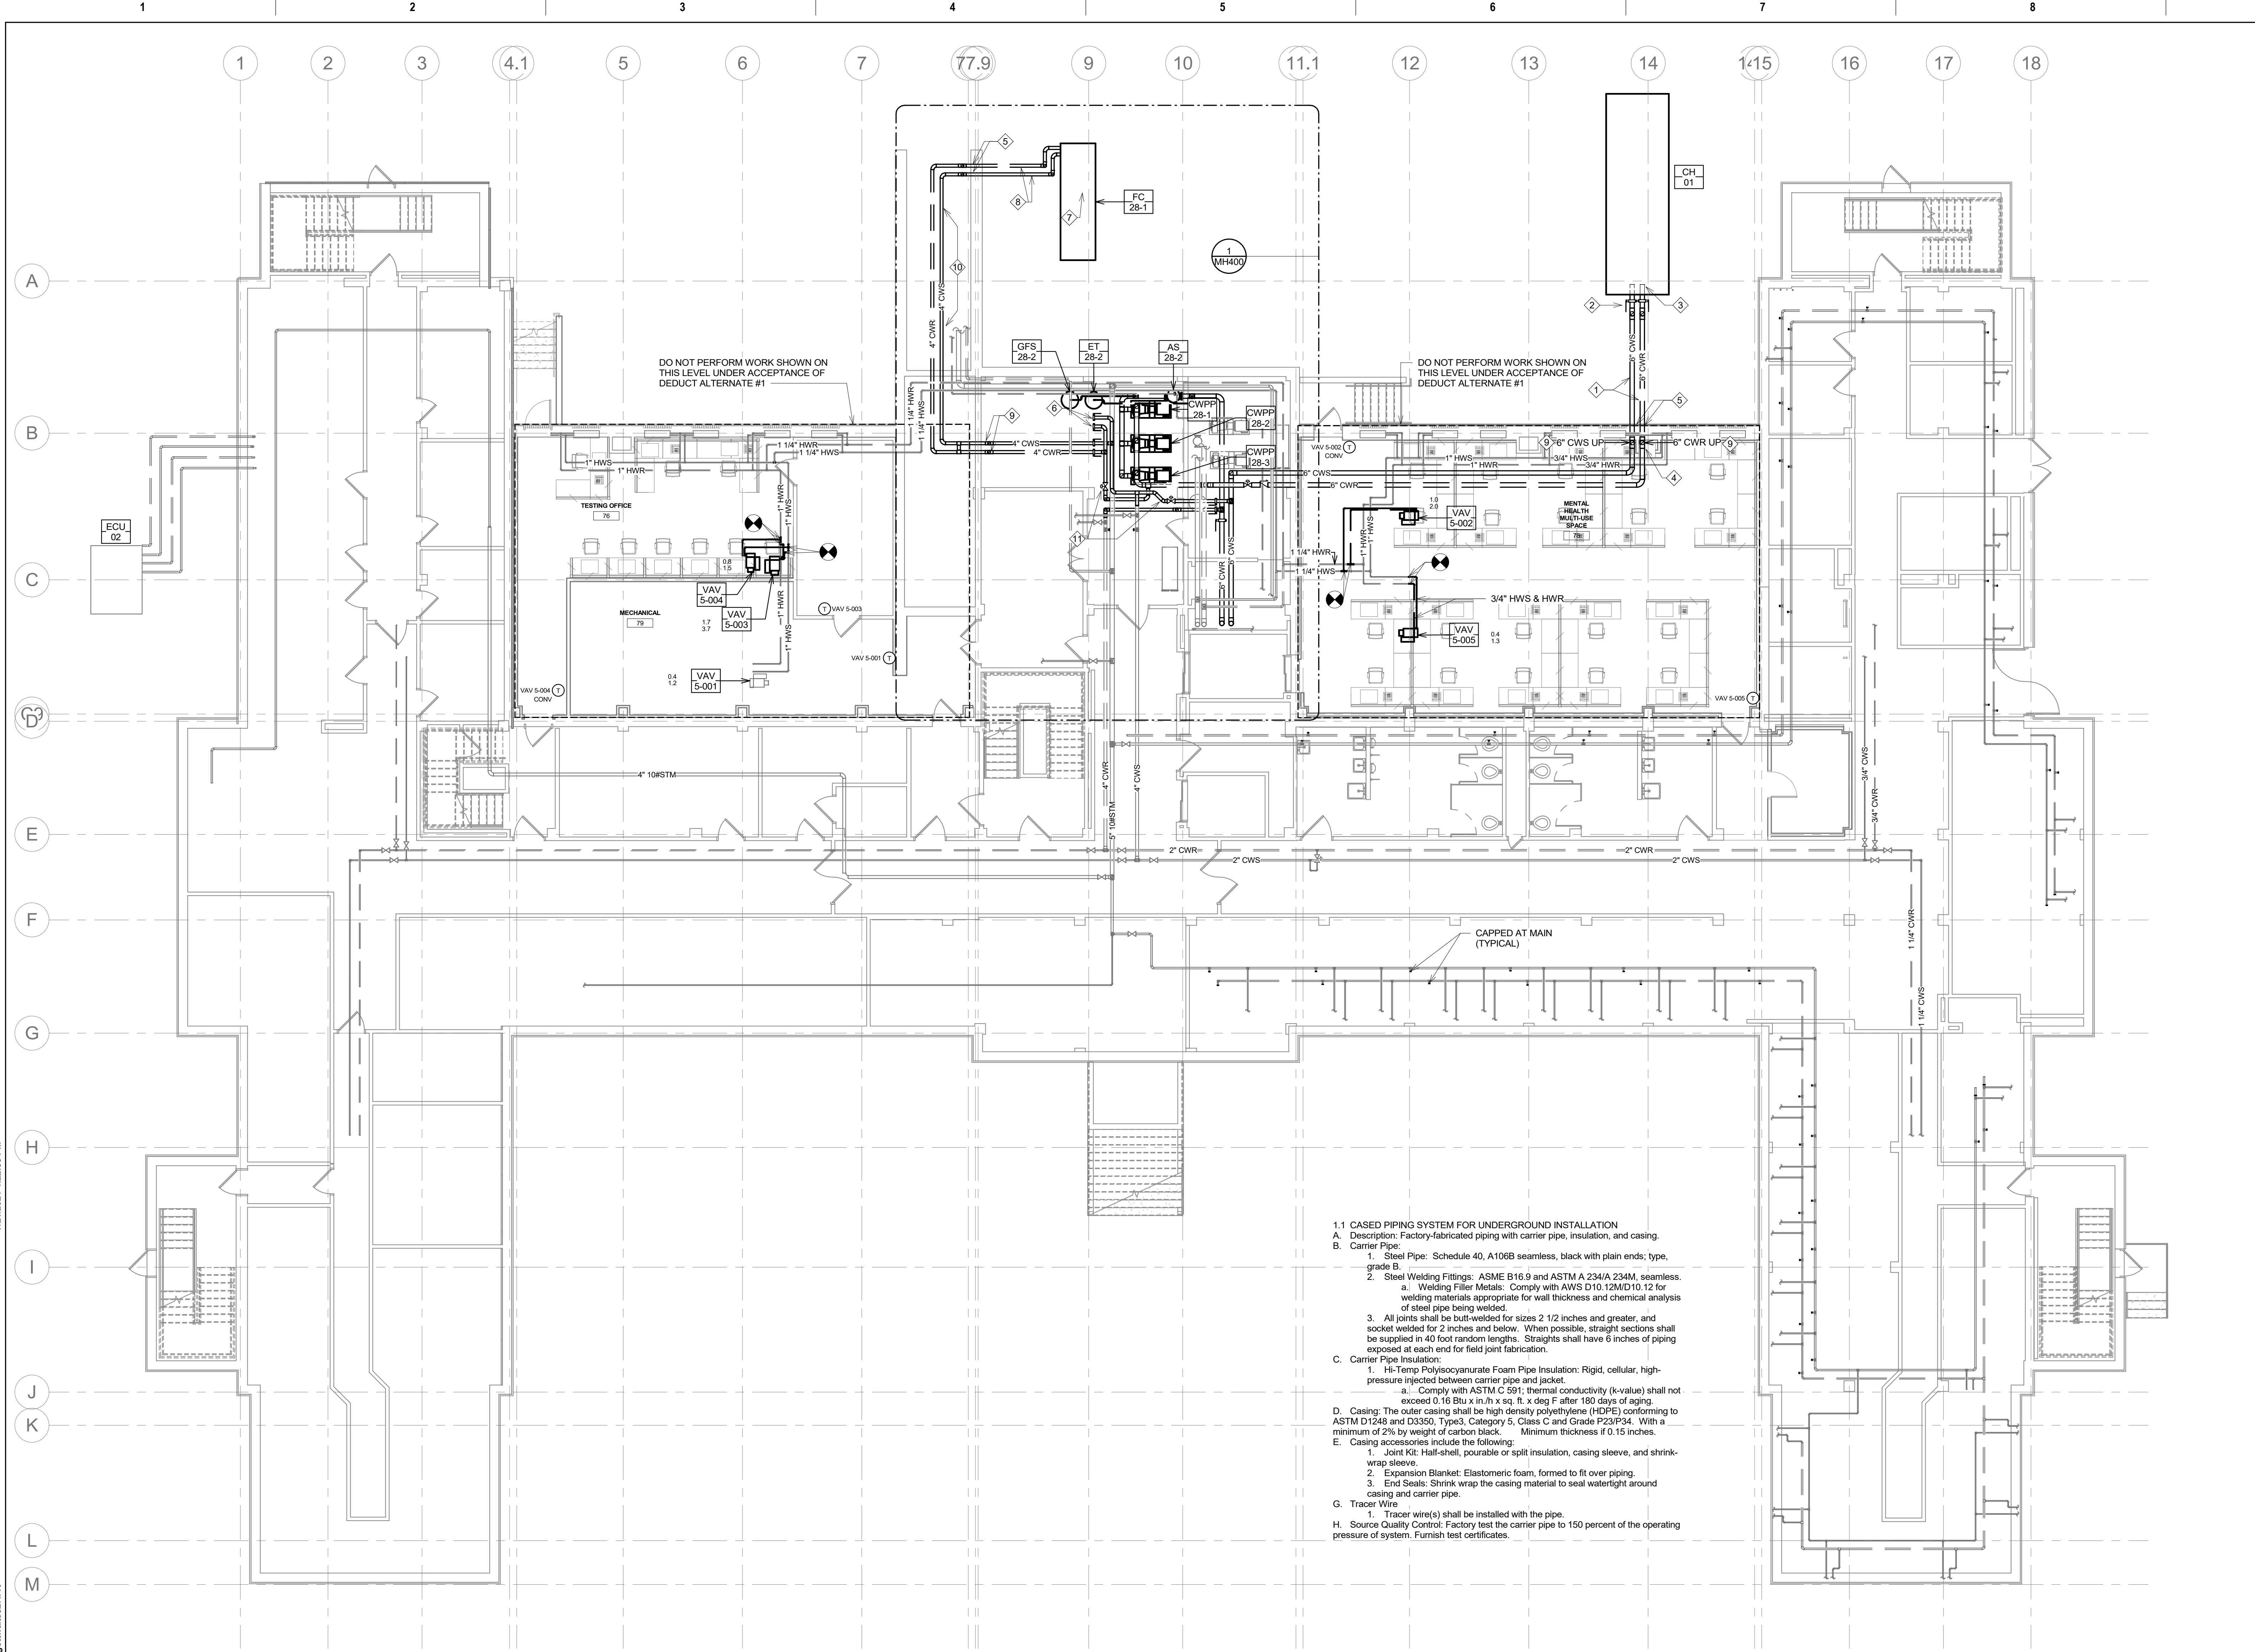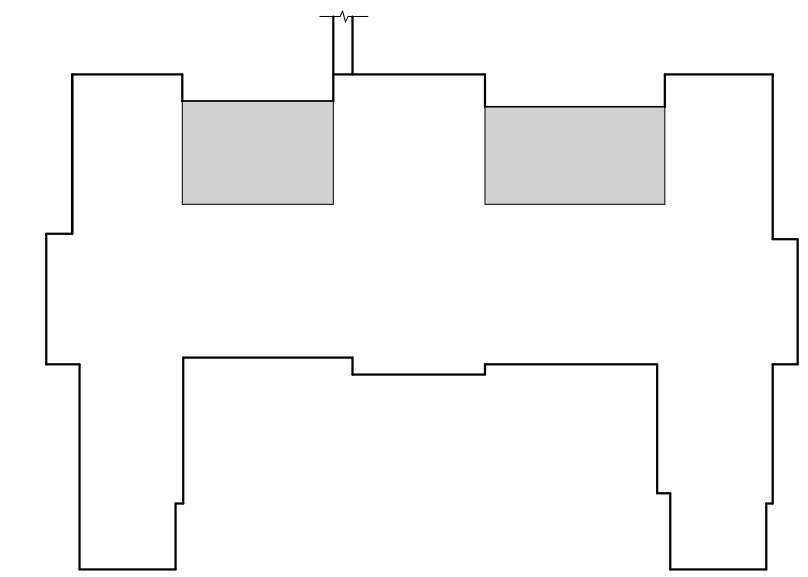

- 1.1 CASED PIPING SYSTEM FOR UNDERGROUND INSTALLATION**
- A. Description: Factory-fabricated piping with carrier pipe, insulation, and casing.
  - B. Carrier Pipe:
    - 1. Steel Pipe: Schedule 40, A106B seamless, black with plain ends; type, grade B.
    - 2. Steel Welding Fittings: ASME B16.9 and ASTM A 234/A 234M, seamless.
      - a. Welding Filler Metals: Comply with AWS D10.12M/D10.12 for welding materials appropriate for wall thickness and chemical analysis of steel pipe being welded.
    - 3. All joints shall be butt-welded for sizes 2 1/2 inches and greater, and socket welded for 2 inches and below. When possible, straight sections shall be supplied in 40 foot random lengths. Straights shall have 6 inches of piping exposed at each end for field joint fabrication.
  - C. Carrier Pipe Insulation:
    - 1. Hi-Temp Polyisocyanurate Foam Pipe Insulation: Rigid, cellular, high-pressure injected between carrier pipe and jacket.
      - a. Comply with ASTM C 591; thermal conductivity (k-value) shall not exceed 0.16 Btu x in/h x sq. ft. x deg F after 180 days of aging.
    - 2. Casing: The outer casing shall be high density polyethylene (HDPE) conforming to ASTM D1248 and D3550, Type3, Category 5, Class C and Grade P23P34. With a minimum of 2% by weight of carbon black. Minimum thickness if 0.15 inches.
  - D. Casing accessories include the following:
    - 1. Joint Kit: Half-shell, pourable or split insulation, casing sleeve, and shrink-wrap sleeve.
    - 2. Expansion Blanket: Elastomeric foam, formed to fit over piping.
    - 3. End Seals: Shrink wrap the casing material to seal watertight around casing and carrier pipe.
  - E. Tracer Wire:
    - 1. Tracer wire(s) shall be installed with the pipe.
  - F. Source Quality Control: Factory test the carrier pipe to 150 percent of the operating pressure of system. Furnish test certificates.

**1 BASEMENT PIPING PLAN**  
1/8" = 1'-0"

Revision#	Description	Date:
AD-2	REVISION SET 2 (PREBID ADDENDUM)	07/23/2021

**CONSULTANT**

**DUNHAM**

50 South Sixth Street / Suite 1100  
 Minneapolis, Minnesota 55402-1540  
 PHONE: 612.465.7550 FAX: 612.465.7551  
 WEB: dunhameng.com  
 mechanical + electrical consulting engineering  
 020950-007-00

**ARCHITECT/ENGINEER OF RECORD**

**ANDERSON**

13605 1st Ave. N. #100 Plymouth, MN 55441  
 P 763.412.4000 | F 763.412.4090 | ae-mn.com  
 Anderson Engineering of Minnesota, LLC | Proj # Project Number

**STAMP**

I hereby certify that this plan, specification or report was prepared by me or under my direct supervision and that I am a duly licensed Professional Engineer under the laws of the State of Minnesota.

Name: Jason R. Gottwalt, P.E.  
 Date: 05/22/2020 Reg. No. 41360

<b>Project Title</b> RENOVATE BUILDING 28 FIRST FLOOR EAST RRTP		
<b>Location</b> SAINT CLOUD, MN		
<b>Phase</b> CONSTRUCTION DOCUMENTS		
<b>Drawing Title</b> BASEMENT PIPING PLAN		
<b>Issue Date</b> MAY 22, 2020	<b>Checked</b> JRG	<b>Drawn</b> TNH

<b>Project Number</b> 656-19-306
<b>Building Number</b> 28
<b>Drawing Number</b> MP101

**U.S. Department of Veterans Affairs**

**Veterans Health Administration**

St. Cloud VA Health Care System


GENERAL NOTES:

- A. MECHANICAL CONTRACTOR WILL BE RESPONSIBLE TO REVIEW ACCESSIBILITY TO AREAS OUTSIDE THE CONSTRUCTION LIMITS TO DETERMINE APPROXIMATE AMOUNT OF OVERTIME REQUIRED TO PERFORM ALL MECHANICAL WORK INDICATED. COORDINATION OF SCHEDULES WITH ADJACENT DEPARTMENTS AND CLEANING OF ALL DEBRIS AFTER EACH WORK SHIFT SHOULD BE ASSUMED IN THE BASE BID SCOPE.
- B. ANY MAJOR OUTAGES INDICATED ON THESE DRAWINGS SHALL BE SCHEDULED TO BE PERFORMED AFTER NORMAL BUSINESS HOURS OR DURING WEEKEND PERIODS TO MINIMIZE DISRUPTION.
- C. COORDINATE ALL NEW PIPE ROUTING WITH ALL OTHER TRADES TO ENSURE ADEQUATE CLEARANCES FOR DUCTWORK, ELECTRICAL CONDUIT, STRUCTURAL SUPPORTS, PIPING, ETC. ANY UNAVOIDABLE CONFLICTS SHALL BE BROUGHT TO THE ATTENTION OF THE ARCHITECT/ENGINEER OF RECORD. PROVIDE ALL OFFSETS AND TRANSITIONS AS REQUIRED FOR A CLEAN INSTALLATION.
- D. SUPPORT ALL PIPING DIRECTLY TO STRUCTURE. DO NOT SUPPORT ANY PIPING FROM DUCTWORK, CONDUIT, OR OTHER PIPING ENCOUNTERED.
- E. WHERE MECHANICAL SYSTEMS TO REMAIN ARE DAMAGED, OR DISTURBED, DURING THE COURSE OF CONSTRUCTION THE CONTRACTOR SHALL BE RESPONSIBLE TO REPAIR DAMAGED PORTIONS AND INSTALL NEW PRODUCTS OF EQUAL QUALITY AND FUNCTIONALITY.
- F. ALL EXISTING PIPING THROUGH NEW FIRE RATED WALLS SHALL BE ADEQUATELY FIRE SEALED AS REQUIRED.
- G. THE MECHANICAL CONTRACTOR SHALL MAINTAIN ACCURATE RECORD DRAWINGS SHOWING ALL DISCREPANCIES WITH ANY EXISTING PIPING INDICATED OR REVISIONS TO THE NEW LAYOUTS. ALL CHANGES WILL BE UPDATED WITHIN THE FINAL RECORD DRAWING SET.
- H. THE SMALLEST ALLOWABLE PIPE SIZE FOR HEATING WATER SUPPLY AND RETURN WILL BE 3/4".
- I. UNLESS NOTED OTHERWISE, HEATING WATER SUPPLY AND RETURN PIPING TAKE-OFFS TO REPEAT COILS SHALL BE 3/4" DIAMETER.
- J. HEATING WATER SUPPLY AND RETURN PIPING TAKE-OFFS SHALL BE OFF THE TOP OF MAIN.
- K. PROVIDE 1/2" DRAIN VALVE AT NEW HEATING WATER SUPPLY AND RETURN PIPE LOW POINTS, DOWNSTREAM OF ISOLATION VALVES.
- L. ALL VALVES TO BE LOCATED ABOVE LAY-IN CEILING FOR ACCESSIBILITY. WHERE VALVES MUST BE LOCATED ABOVE GYPSUM BOARD CEILING, MECHANICAL CONTRACTOR SHALL COORDINATE LOCATIONS OF 24"x24" ACCESS PANELS WITH GENERAL CONTRACTOR.

KEY NOTES:

- 1 EXISTING 6" HEATING WATER SUPPLY AND RETURN AND 2" LOW PRESSURE STEAM UP AND DOWN.
- 2 ROUTE 3/4" HEATING WATER SUPPLY AND RETURN DOWN IN WALL AND CONNECT TO EXISTING CONVECTOR.
- 3 ROUTE 3/4" HEATING WATER SUPPLY AND RETURN DOWN IN WALL AND CONNECT TO NEW CONVECTOR(S). INCLUDE WORK ASSOCIATED WITH OPENING UP EXTERIOR WALL FOR PIPING INSTALLATION (AND DEMO OF OLD STEAM PIPING RISERS WHERE APPLICABLE). NOTE THAT CONTROL VALVE, STRAINER, BALANCING AND ISOLATION VALVES SHALL ALL BE LOCATED OUTSIDE OF THE PATIENT ROOM IN LOCATION WITH DIRECT ACCESS TO CORRESPONDING VAV REHEAT COIL CONTROL VALVE.
- 4 DASHED SQUARE BOX REPRESENTS 24"x24" ACCESS AREA FOR BOTH VAV BOX ACTUATOR, AND THE REHEAT COIL PIPING COMPONENTS SHOWN ON DETAIL 10M/500. NOTE THAT VAV'S PREFERENCE IS TO PROVIDE PRE-PIPED VALVE KITS AS SPECIFIED IN EQUIPMENT SCHEDULE. VERIFY THERE IS ENOUGH CLEARANCE FOR INSTALLATION OF THESE KITS, OR MODIFY THEM AS REQUIRED.
- 5 PROVIDE 24" x 24" ACCESS PANEL IN GYPSUM CEILING. COORDINATE LOCATION WITH GENERAL CONTRACTOR.
- 6 BALANCE TO 1 GPM.
- 7 BALANCE TO 2 GPM.
- 8 BALANCE TO 3 GPM.
- 9 BALANCE TO 4 GPM.
- 10 2-1/2" HEATING WATER SUPPLY AND RETURN PIPING CAPPED AND VALVED FOR FUTURE EXPANSION LOOP TO WEST SIDE OF BUILDING.
- 11 LOCATE CONTROL VALVES AND ASSOCIATED PIPING COMPONENTS IN CORRIDOR CEILING PLENUM. SHOWN HERE FOR CLARITY.
- 12 CONTRACTOR TO OPEN RATED CHASE/SHAFT TO ALLOW ACCESS TO INSTALL NEW CHILLED WATER PIPING RISERS NEXT TO EXISTING HEATING WATER RISERS. COORDINATE EXACT CONFIGURATION OF CHASE TO DETERMINE AMOUNT OF DEMOLITION AND REBUILDING OF RATED SHAFT WALL IS REQUIRED. ALL RISER PIPING FLOOR PENETRATIONS TO BE PROVIDED WITH FLOOR SLEEVE RAISED 2" ABOVE FLOOR LEVEL TO PREVENT POTENTIAL WATER/FLOODING FROM PENETRATING INTO LOWER LEVELS.
- 13 COORDINATE EXTENSION OF NEW CHILLED WATER RISERS UP TO ATTIC SPACE. REFER TO BASEMENT LEVEL BELOW, AND SECOND FLOOR ABOVE. PIPING PLANS FOR CONTINUATION.
- 14 RECONNECT HEATING WATER SUPPLY/RETURN PIPING TO EXISTING CONVECTORS AND PROVIDE ALL NEW CONTROL VALVES AND PIPING COMPONENTS ABOVE CEILING WITH ADEQUATE ACCESS AS REQUIRED.
- 15 PROVIDE A TEMPERATURE MONITOR WITHIN EACH REFRIGERATOR STORING PATIENT DRUGS AND/OR FOOD. THREE (3) MONITORS SHALL BE INCLUDED WITHIN THIS PROJECT INSTALLED IN KITCHENETTE AREA, MEDS ROOM, AND SPD CLOSET. COORDINATE EXACT MODEL TO INCORPORATE INTO ST. CLOUD VA WIRELESS DATA FOR TRENDS LOGGING AND REMOTE ALARMS TO BUILDING AUTOMATION SYSTEM.

KEY PLAN

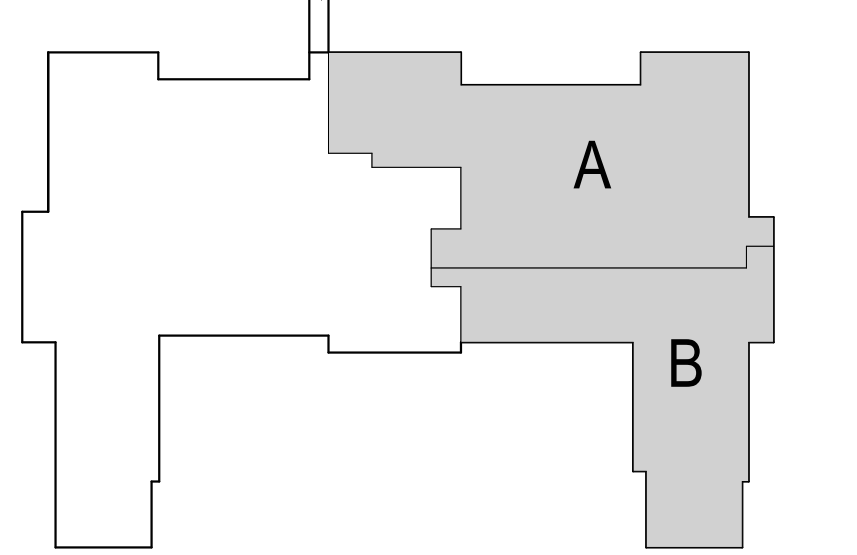

1 FIRST FLOOR PIPING PLAN  
1/8" = 1'-0"

Revision#	Description	Date:
AD-2	REVISION SET 2 (PREBID ADDENDUM)	07/23/2021
AD-1	REVISION SET 1 (PREBID ADDENDUM)	06/15/2021

**CONSULTANT**  
**DUNHAM**  
50 South Sixth Street / Suite 1100  
Minneapolis, Minnesota 55402-1540  
PHONE: 612.465.7550 FAX: 612.465.7551  
WEB: dunhameng.com  
mechanical + electrical consulting engineering  
020959-007-00

**ARCHITECT/ENGINEER OF RECORD**  
**ANDERSON**  
13605 1st Ave. N. #100 Plymouth, MN 55441  
P 763.412.4000 | F 763.412.4090 | ae-mn.com  
Anderson Engineering of Minnesota, LLC | Proj # Project Number

**STAMP**  
I hereby certify that this plan, specification or report was prepared by me or under my direct supervision and that I am a duly licensed Professional Engineer under the laws of the State of Minnesota.  
Name: Jason R. Gottwalt, P.E.  
Date: 05/22/2020 Reg. No. 41360

**Project Title**  
RENOVATE BUILDING 28  
FIRST FLOOR EAST RTRP

**Location**  
SAINT CLOUD, MN

**Phase**  
CONSTRUCTION DOCUMENTS

**Drawing Title**  
FIRST FLOOR PIPING PLAN

**Issue Date**  
MAY 22, 2020

**Checked**  
JRG

**Drawn**  
TNH

**Project Number**  
656-19-306

**Building Number**  
28

**Drawing Number**  
MP111

**U.S. Department of Veterans Affairs**  
Veterans Health Administration  
St. Cloud VA Health Care System

CHILLER SCHEDULE - AIR COOLED

MECHANICAL (236423 & 236426)

Table with columns: EQUIPMENT TAG, APPLICATION, TYPE, RATING POINT, EVAPORATOR (WATER SIDE), COMPRESSOR, MECHANICAL NOTES. Includes callouts AD-1 and AD-2.

GENERAL MECHANICAL NOTES:

A. REFER TO ELECTRICAL SECTION BELOW FOR CALCULATED SHORT-CIRCUIT CURRENT AT EQUIPMENT.

MECHANICAL NOTES:

- 1. VERIFY THAT CHILLER CONTROLLER IS COMPATIBLE WITH BACNET COMMUNICATION WITH JOHNSON CONTROLS CAMPUS AUTOMATION SYSTEM. INTERLOCK PRIMARY PUMPS WITH CHILLER CONTROL PANEL VIA BAS. REFER TO SEQUENCE OF OPERATION.
2. INCLUDE VFD'S FOR ALL SCROLL COMPRESSORS FOR LOW PARTIAL LOAD CONDITIONS AT HIGH EFFICIENCY. REFER TO DRAWINGS FOR MINIMUM FLOW BYPASS VALVE SET FOR CHILLER MANUFACTURER'S LOW LIMIT REQUIREMENT.

ELECTRICAL

Table with columns: EQUIPMENT TAG, HP/LOAD, VOLTAGE, PHASE, CALCULATED AFC, TYPE, FURNISHED BY/ INSTALLED BY, LOCATION, CTRL WIRE BY, AMPS/TYPE, FUSE SIZE (AMPS), NEMA TYPE, FURNISHED BY/ INSTALLED BY, LOCATION, PANEL, CIRCUIT NUMBER, CONDUIT/FEEDER SIZE, ELECTRICAL NOTES.

GENERAL ELECTRICAL NOTES:

- A. WHEN THE CONTROLLER TYPE IS A VFD OR MAGNETIC STARTER, REFER TO THE VARIABLE FREQUENCY DRIVE CONTROLLER SCHEDULE OR THE MAGNETIC STARTER SCHEDULE FOR MORE INFORMATION.
B. MECHANICAL EQUIPMENT AND CORRESPONDING ELECTRICAL DISCONNECTS/CONTROLLERS SHALL HAVE A STANDARD SHORT-CIRCUIT CURRENT RATING HIGHER THAN THE CALCULATED VALUE SHOWN IN THIS SCHEDULE, DETAILED BY THE "CALCULATED AFC" COLUMN.

ELECTRICAL NOTES:

HYDRONIC PUMP SCHEDULE

MECHANICAL (232123)

Table with columns: EQUIPMENT TAG, APPLICATION, TYPE, DISCHARGE GPM HEAD (FT), GLYCOL TYPE, GLYCOL %, NPSHR (FT), RPM, BHP, SUCTION SIZE (IN), DISCHARGE SIZE (IN), TRIPLE DUTY VALVE, SUCTION DIFFUSER, VFD (YES/NO), MANUFACTURER, MODEL NUMBER, MECHANICAL NOTES.

GENERAL MECHANICAL NOTES:

A. REFER TO ELECTRICAL SECTION BELOW FOR CALCULATED SHORT-CIRCUIT CURRENT AT EQUIPMENT.

MECHANICAL NOTES:

- 1. PROVIDE A 4" CONCRETE EQUIPMENT PAD FOR ALL FLOOR MOUNTED PUMPS. CONTRACTOR TO VERIFY FRAME TYPE AND SECURE WITH ANCHOR BOLTS WHILE SITTING ON TOP OF NEAPRENE PADS (INERTIA BASES WILL NOT BE REQUIRED FOR THIS SLAB ON GRADE INSTALLATION).
2. REFERENCE PIPING DIAGRAMS FOR INSTALLATION OF ALL REQUIRED ISOLATION VALVES, PRESSURE GAUGES, TRIPLE DUTY VALVES, SUCTION DIFFUSERS, ECT FOR EACH PUMP INSTALLATION TO BE COMPLETE.

ELECTRICAL

Table with columns: EQUIPMENT TAG, HP/LOAD, VOLTAGE, PHASE, CALCULATED AFC, TYPE, FURNISHED BY/ INSTALLED BY, LOCATION, CTRL WIRE BY, AMPS/TYPE, FUSE SIZE (AMPS), NEMA TYPE, FURNISHED BY/ INSTALLED BY, LOCATION, PANEL, CIRCUIT NUMBER, CONDUIT/FEEDER SIZE, ELECTRICAL NOTES.

GENERAL ELECTRICAL NOTES:

- A. WHEN THE CONTROLLER TYPE IS A VFD OR MAGNETIC STARTER, REFER TO THE VARIABLE FREQUENCY DRIVE CONTROLLER SCHEDULE OR THE MAGNETIC STARTER SCHEDULE FOR MORE INFORMATION.
B. MECHANICAL EQUIPMENT AND CORRESPONDING ELECTRICAL DISCONNECTS/CONTROLLERS SHALL HAVE A STANDARD SHORT-CIRCUIT CURRENT RATING HIGHER THAN THE CALCULATED VALUE SHOWN IN THIS SCHEDULE, DETAILED BY THE "CALCULATED AFC" COLUMN.

ELECTRICAL NOTES:

FLUID COOLER SCHEDULE

MECHANICAL (236510)

Table with columns: EQUIPMENT TAG, LOCATION, APPLICATION, NUMBER OF FANS, NUMBER OF MOTORS, MOTOR HP (EACH), TOTAL CFM, PERFORMANCE GPM, EWT (F), LWT (F), AMBIENT AIR DB (F), WPD (FT), GLYCOL TYPE, GLYCOL %, VFD (YES/NO), MANUFACTURER, MODEL NUMBER, MECHANICAL NOTES.

GENERAL MECHANICAL NOTES:

A. REFER TO ELECTRICAL SECTION BELOW FOR CALCULATED SHORT-CIRCUIT CURRENT AT EQUIPMENT.

MECHANICAL NOTES:

- 1. PROVIDE FLUID COOLER WITH NEW CONCRETE EQUIPMENT PAD INSTALLED AT LOCATION INDICATED ON PLANS. CONFIRM FINAL DIMENSIONS OF PAD WITH MANUFACTURER SHOP DRAWINGS.
2. INCLUDE VFD CONTROL FOR ALL FLUID COOLER FANS. REFER TO SEQUENCE OF OPERATION FOR FAN STAGING.

ELECTRICAL

Table with columns: EQUIPMENT TAG, HP/LOAD, VOLTAGE, PHASE, CALCULATED AFC, TYPE, FURNISHED BY/ INSTALLED BY, LOCATION, CTRL WIRE BY, AMPS/TYPE, FUSE SIZE (AMPS), NEMA TYPE, FURNISHED BY/ INSTALLED BY, LOCATION, PANEL, CIRCUIT NUMBER, CONDUIT/FEEDER SIZE, ELECTRICAL NOTES.

GENERAL ELECTRICAL NOTES:

- A. WHEN THE CONTROLLER TYPE IS A VFD OR MAGNETIC STARTER, REFER TO THE VARIABLE FREQUENCY DRIVE CONTROLLER SCHEDULE OR THE MAGNETIC STARTER SCHEDULE FOR MORE INFORMATION.
B. MECHANICAL EQUIPMENT AND CORRESPONDING ELECTRICAL DISCONNECTS/CONTROLLERS SHALL HAVE A STANDARD SHORT-CIRCUIT CURRENT RATING HIGHER THAN THE CALCULATED VALUE SHOWN IN THIS SCHEDULE, DETAILED BY THE "CALCULATED AFC" COLUMN.

ELECTRICAL NOTES:

FAN SCHEDULE

MECHANICAL (233413, 233416, 233423)

Table with columns: EQUIPMENT TAG, APPLICATION, TYPE, CFM, ESP (IN W.C.), BHP, FAN RPM, DRIVE TYPE, SONES, VFD (YES/NO), MANUFACTURER, MODEL NUMBER, MECHANICAL NOTES.

GENERAL MECHANICAL NOTES:

A. REFER TO ELECTRICAL SECTION BELOW FOR CALCULATED SHORT-CIRCUIT CURRENT AT EQUIPMENT.

MECHANICAL NOTES:

ELECTRICAL

Table with columns: EQUIPMENT TAG, HP/LOAD, VOLTAGE, PHASE, CALCULATED AFC, TYPE, FURNISHED BY/ INSTALLED BY, LOCATION, CTRL WIRE BY, AMPS/TYPE, FUSE SIZE (AMPS), NEMA TYPE, FURNISHED BY/ INSTALLED BY, LOCATION, PANEL, CIRCUIT NUMBER, CONDUIT/FEEDER SIZE, ELECTRICAL NOTES.

GENERAL ELECTRICAL NOTES:

- A. WHEN THE CONTROLLER TYPE IS A VFD OR MAGNETIC STARTER, REFER TO THE VARIABLE FREQUENCY DRIVE CONTROLLER SCHEDULE OR THE MAGNETIC STARTER SCHEDULE FOR MORE INFORMATION.
B. MECHANICAL EQUIPMENT AND CORRESPONDING ELECTRICAL DISCONNECTS/CONTROLLERS SHALL HAVE A STANDARD SHORT-CIRCUIT CURRENT RATING HIGHER THAN THE CALCULATED VALUE SHOWN IN THIS SCHEDULE, DETAILED BY THE "CALCULATED AFC" COLUMN.

ELECTRICAL NOTES:

I hereby certify that this plan, specification or report was prepared by me or under my direct supervision and that I am a duly Licensed Professional Engineer under the laws of the State of Minnesota.

Name Curtis D. Barlage, P.E. Date 05/22/2020 Reg. No. 45914

STAMP ARCHITECT/ENGINEER OF RECORD ANDERSON 13605 1st Ave. N., #100 Plymouth, MN 55441 P 763.412.4000 | F 763.412.4090 | ae-mn.com Anderson Engineering of Minnesota, LLC | Proj # Project Number.

Name Jason R. Gottwalt, P.E. Date 05/22/2020 Reg. No. 41360

Table with columns: Revision#, Description, Date. Includes revisions AD-2 and AD-1.

CONSULTANT DUNHAM 50 South Sixth Street / Suite 1100 Minneapolis, Minnesota 55402-1540 PHONE 612.465.7550 FAX 612.465.7551 www.dunhameng.com mechanical + electrical consulting engineering 020950-007-00



ARCHITECT/ENGINEER OF RECORD ANDERSON 13605 1st Ave. N., #100 Plymouth, MN 55441 P 763.412.4000 | F 763.412.4090 | ae-mn.com Anderson Engineering of Minnesota, LLC | Proj # Project Number.

Project Title RENOVATE BUILDING 28 FIRST FLOOR EAST RTPT Location SAINT CLOUD, MN Phase CONSTRUCTION DOCUMENTS Drawing Title MECHANICAL/ ELECTRICAL SCHEDULES Issue Date MAY 22, 2020 Checked Drawn Project Number 656-19-306 Building Number 28 Drawing Number MH602

U.S. Department of Veterans Affairs Veterans Health Administration St. Cloud VA Health Care System

7/21/2021 4:22:21 PM

three inches = one foot  
one and one-half inches = one foot  
one inch = one foot  
three-quarters inch = one foot  
one-half inch = one foot  
one-quarter inch = one foot  
three eighths inch = one foot  
one-eighth inch = one foot  
one sixteenth inch = one foot  
one-thirty-second inch = one foot

VARIABLE FREQUENCY MOTOR CONTROLLER SCHEDULE  
MECHANICAL/ELECTRICAL (230923)  
Table with columns: EQUIPMENT TAG, VOLTAGE, PHASE, ENCLOSURE TYPE, ENCLOSURE PLENUM RATED, SEISMIC BRACING, VARIABLE TORQUE/CONSTANT TORQUE, HARMONIC CONTROL (INPUT AC LINE, OUTPUT AC LINE, BYPASS), BYPASS TYPE, BYPASS CONTROL, MOTOR STARTING IN BYPASS MODE, MULTIPLE MOTOR CONTROL, DAMPER CONTROL, ESSENTIAL SERVICE/FIRE FIGHTER MODE, LEED REQUIREMENTS, NOTES.

GLYCOL FILL STATION SCHEDULE  
MECHANICAL (232113)  
Table with columns: EQUIPMENT TAG, APPLICATION, NUMBER OF PUMPS, GPM, DISCHARGE HEAD, MOTOR HP, RPM, VOLTAGE/PHASE, TANK CAPACITY, MANUFACTURER, MODEL NUMBER, MECHANICAL NOTES.

ELECTRICAL  
Table with columns: EQUIPMENT TAG, HP/LOAD, VOLTAGE, PHASE, CALCULATED AFC, TYPE, FURNISHED BY, LOCATION, CTRL WIRE BY, AMPS/TYPE, FUSE SIZE, NEMA TYPE, DISCONNECT AT MOTOR, FURNISHED BY, LOCATION, PANEL, CIRCUIT NUMBER, CONDUIT/FEEDER SIZE, ELECTRICAL NOTES.

UNIT HEATER SCHEDULE - HEATING WATER  
MECHANICAL (238239)  
Table with columns: EQUIPMENT TAG, APPLICATION, TYPE, FAN (CFM, MOTOR HP, EAT, COIL ROWS, EWT, LWT), COIL (GPM, GLYCOL TYPE, WPD, CAPACITY), MANUFACTURER, MODEL NUMBER, MECHANICAL NOTES.

ELECTRICAL  
Table with columns: EQUIPMENT TAG, HP/LOAD, VOLTAGE, PHASE, CALCULATED AFC, TYPE, FURNISHED BY, LOCATION, CTRL WIRE BY, AMPS/TYPE, FUSE SIZE, NEMA TYPE, DISCONNECT AT MOTOR, FURNISHED BY, LOCATION, PANEL, CIRCUIT NUMBER, CONDUIT/FEEDER SIZE, ELECTRICAL NOTES.

GENERAL ELECTRICAL NOTES:  
A. WHEN THE CONTROLLER TYPE IS A VFD OR MAGNETIC STARTER, REFER TO THE VARIABLE FREQUENCY DRIVE CONTROLLER SCHEDULE OR THE MAGNETIC STARTER SCHEDULE FOR MORE INFORMATION.  
B. MECHANICAL EQUIPMENT AND CORRESPONDING ELECTRICAL DISCONNECTS/CONTROLLERS SHALL HAVE A STANDARD SHORT-CIRCUIT CURRENT RATING HIGHER THAN THE CALCULATED VALUE SHOWN IN THIS SCHEDULE, DETAILED BY THE "CALCULATED AFC" COLUMN.

I hereby certify that this plan, specification or report was prepared by me or under my direct supervision and that I am a Licensed Professional Engineer under the laws of the State of Minnesota.  
Name: Curtis D. Barlage, P.E.  
Date: 05/22/2020  
Reg. No.: 45914

I hereby certify that this plan, specification or report was prepared by me or under my direct supervision and that I am a Licensed Professional Engineer under the laws of the State of Minnesota.  
Name: Jason R. Gottwalt, P.E.  
Date: 05/22/2020  
Reg. No.: 41360

CONSULTANT  
DUNHAM  
50 South Sixth Street / Suite 1100  
Minneapolis, Minnesota 55402-1540  
PHONE: 612.465.7550 FAX: 612.465.7551  
www.dunham.com  
mechanical + electrical consulting engineering 652950.007-00

ARCHITECT/ENGINEER OF RECORD  
STAMP  
ANDERSON  
13605 1st Ave. N., #100 Plymouth, MN 55441  
P 763.412.4000 | F 763.412.4090 | ae-mn.com  
Anderson Engineering of Minnesota, LLC | Proj # Project Number

Project Title  
RENOVATE BUILDING 28  
FIRST FLOOR EAST RTTP  
Location  
SAINT CLOUD, MN  
Phase  
CONSTRUCTION DOCUMENTS  
Drawing Title  
MECHANICAL/ ELECTRICAL  
SCHEDULES  
Issue Date  
MAY 22, 2020  
Checked  
JRG  
Drawn  
TNH

Project Number  
656-19-306  
Building Number  
28  
Drawing Number  
MH603

U.S. Department of Veterans Affairs  
Veterans Health Administration  
St. Cloud VA Health Care System



**GENERAL NOTES:**

- A. BUILDING WILL BE IN USE DURING CONSTRUCTION. SCHEDULE AND CARRY OUT THE WORK IN SUCH A MANNER AS TO CAUSE THE OWNER A MINIMUM OF INCONVENIENCE DUE TO SERVICE INTERRUPTION. TEMPORARY SERVICES (FEEDER, BRANCH CIRCUIT, AND SIGNAL SYSTEMS) SHALL BE INSTALLED IF ONE AREA OR PHASE OF CONSTRUCTION DISRUPTS SERVICE TO ANOTHER AREA OF THE BUILDING(S) OR IF THE EQUIPMENT, CONDUITS, OR FEEDERS HAVE TO BE RELOCATED TO ALLOW CONSTRUCTION TO PROGRESS. SERVICE INTERRUPTIONS SHALL BE CONFINED TO THE SMALLEST AREA POSSIBLE AT ANY ONE TIME AND INTERRUPTIONS SHALL BE SCHEDULED WITH THE OWNER'S SITE REPRESENTATIVE. THERE SHALL BE DESIGNATED AREAS WHERE INTERRUPTIONS LIMITED TO AND SHALL BE CONDUCTED AFTER HOURS (8:00 PM-6:00 AM) MONDAY THROUGH SATURDAY. AFTER SERVICE HAS BEEN RESTORED FOLLOWING AN INTERRUPTION, INSPECT AREAS AFFECTED BY THE INTERRUPTION AND BE RESPONSIBLE FOR RETURNING AUTOMATICALLY CONTROLLED EQUIPMENT TO THE SAME OPERATING CONDITION WHICH EXISTED PRIOR TO THE INTERRUPTION.
- B. SIGNIFICANT NOISE PRODUCING WORK SHALL BE CONDUCTED AFTER HOURS (8:00 PM-6:00 AM) AND WEEKENDS.
- C. DO NOT REUSE EXISTING WIRING. PROVIDE NEW HOME RUNS UNLESS NOTED OTHERWISE. PROVIDE DEDICATED NEUTRALS AS REQUIRED BY THE NEC. HANDLE TIES OR MULTI POLE BREAKERS FOR SINGLE PHASE LOADS ARE UNACCEPTABLE.
- D. COORDINATE LOCATION AND INSTALLATION OF CEILING MOUNTED EQUIPMENT WITH THE VA PRIOR TO ROUGH-IN.
- E. INSTALL MINIMUM #10 AWG FOR ALL 120V CIRCUIT HOMERUNS IN EXCESS OF 75'.
- F. ROUTE CONDUITS IN A MANNER TO CONCEAL WHERE POSSIBLE.
- G. DEVICES SHOWN BACK-TO-BACK ARE FOR INTENT PURPOSES ONLY. DO NOT INSTALL BACK-TO-BACK TO PREVENT NOISE TRAVEL. SEE SPECIFICATIONS FOR ADDITIONAL INFORMATION.
- H. ALL FURNITURE LAYOUTS ARE SHOWN FOR DESIGN INTENT ONLY. FINAL LOCATIONS OF FURNITURE AND ASSOCIATED POWER/DATA OUTLETS TO BE COORDINATED WITH OWNER.
- I. REFER TO MECHANICAL ELECTRICAL (ME) SCHEDULES FOR ELECTRICAL CONNECTION REQUIREMENTS TO MECHANICAL EQUIPMENT.
- J. COORDINATE RECEPTACLE DEVICES NEXT TO COMMUNICATION DEVICES, SUCH THAT THE DEVICES ARE MOUNTED NEXT TO EACH OTHER.
- K. UNLESS NOTED OTHERWISE, NORMAL POWER-FED DEVICES AND EQUIPMENT ARE CIRCUITED TO PANEL 28-L1-3. CRITICAL POWER-FED DEVICES AND EQUIPMENT ARE CIRCUITED TO PANEL 28-EC1-2.

**KEY NOTES:**

- ① PROVIDE DOUBLE GANG DEEP JUNCTION BOX WITH SINGLE GANG MUDRING, BLANK COVER PLATE AND A 3/4" CONDUIT STUB TO CABLE TRAY FOR FUTURE USE.
- ② PROVIDE CONDUIT(S) UNDER FLOOR BELOW TO DEVICES IN ISLANDS.
- ③ MOUNT DEVICES TO OWNER PROVIDED FURNITURE.
- ④ PROVIDE CONNECTION FOR EBR-01 WALL HEATER.
- ⑤ PROVIDE SEPERATE CONDUIT FOR CRITICAL POWER.
- ⑥ MOUNT DEVICE HORIZONTAL.

**KEY PLAN**

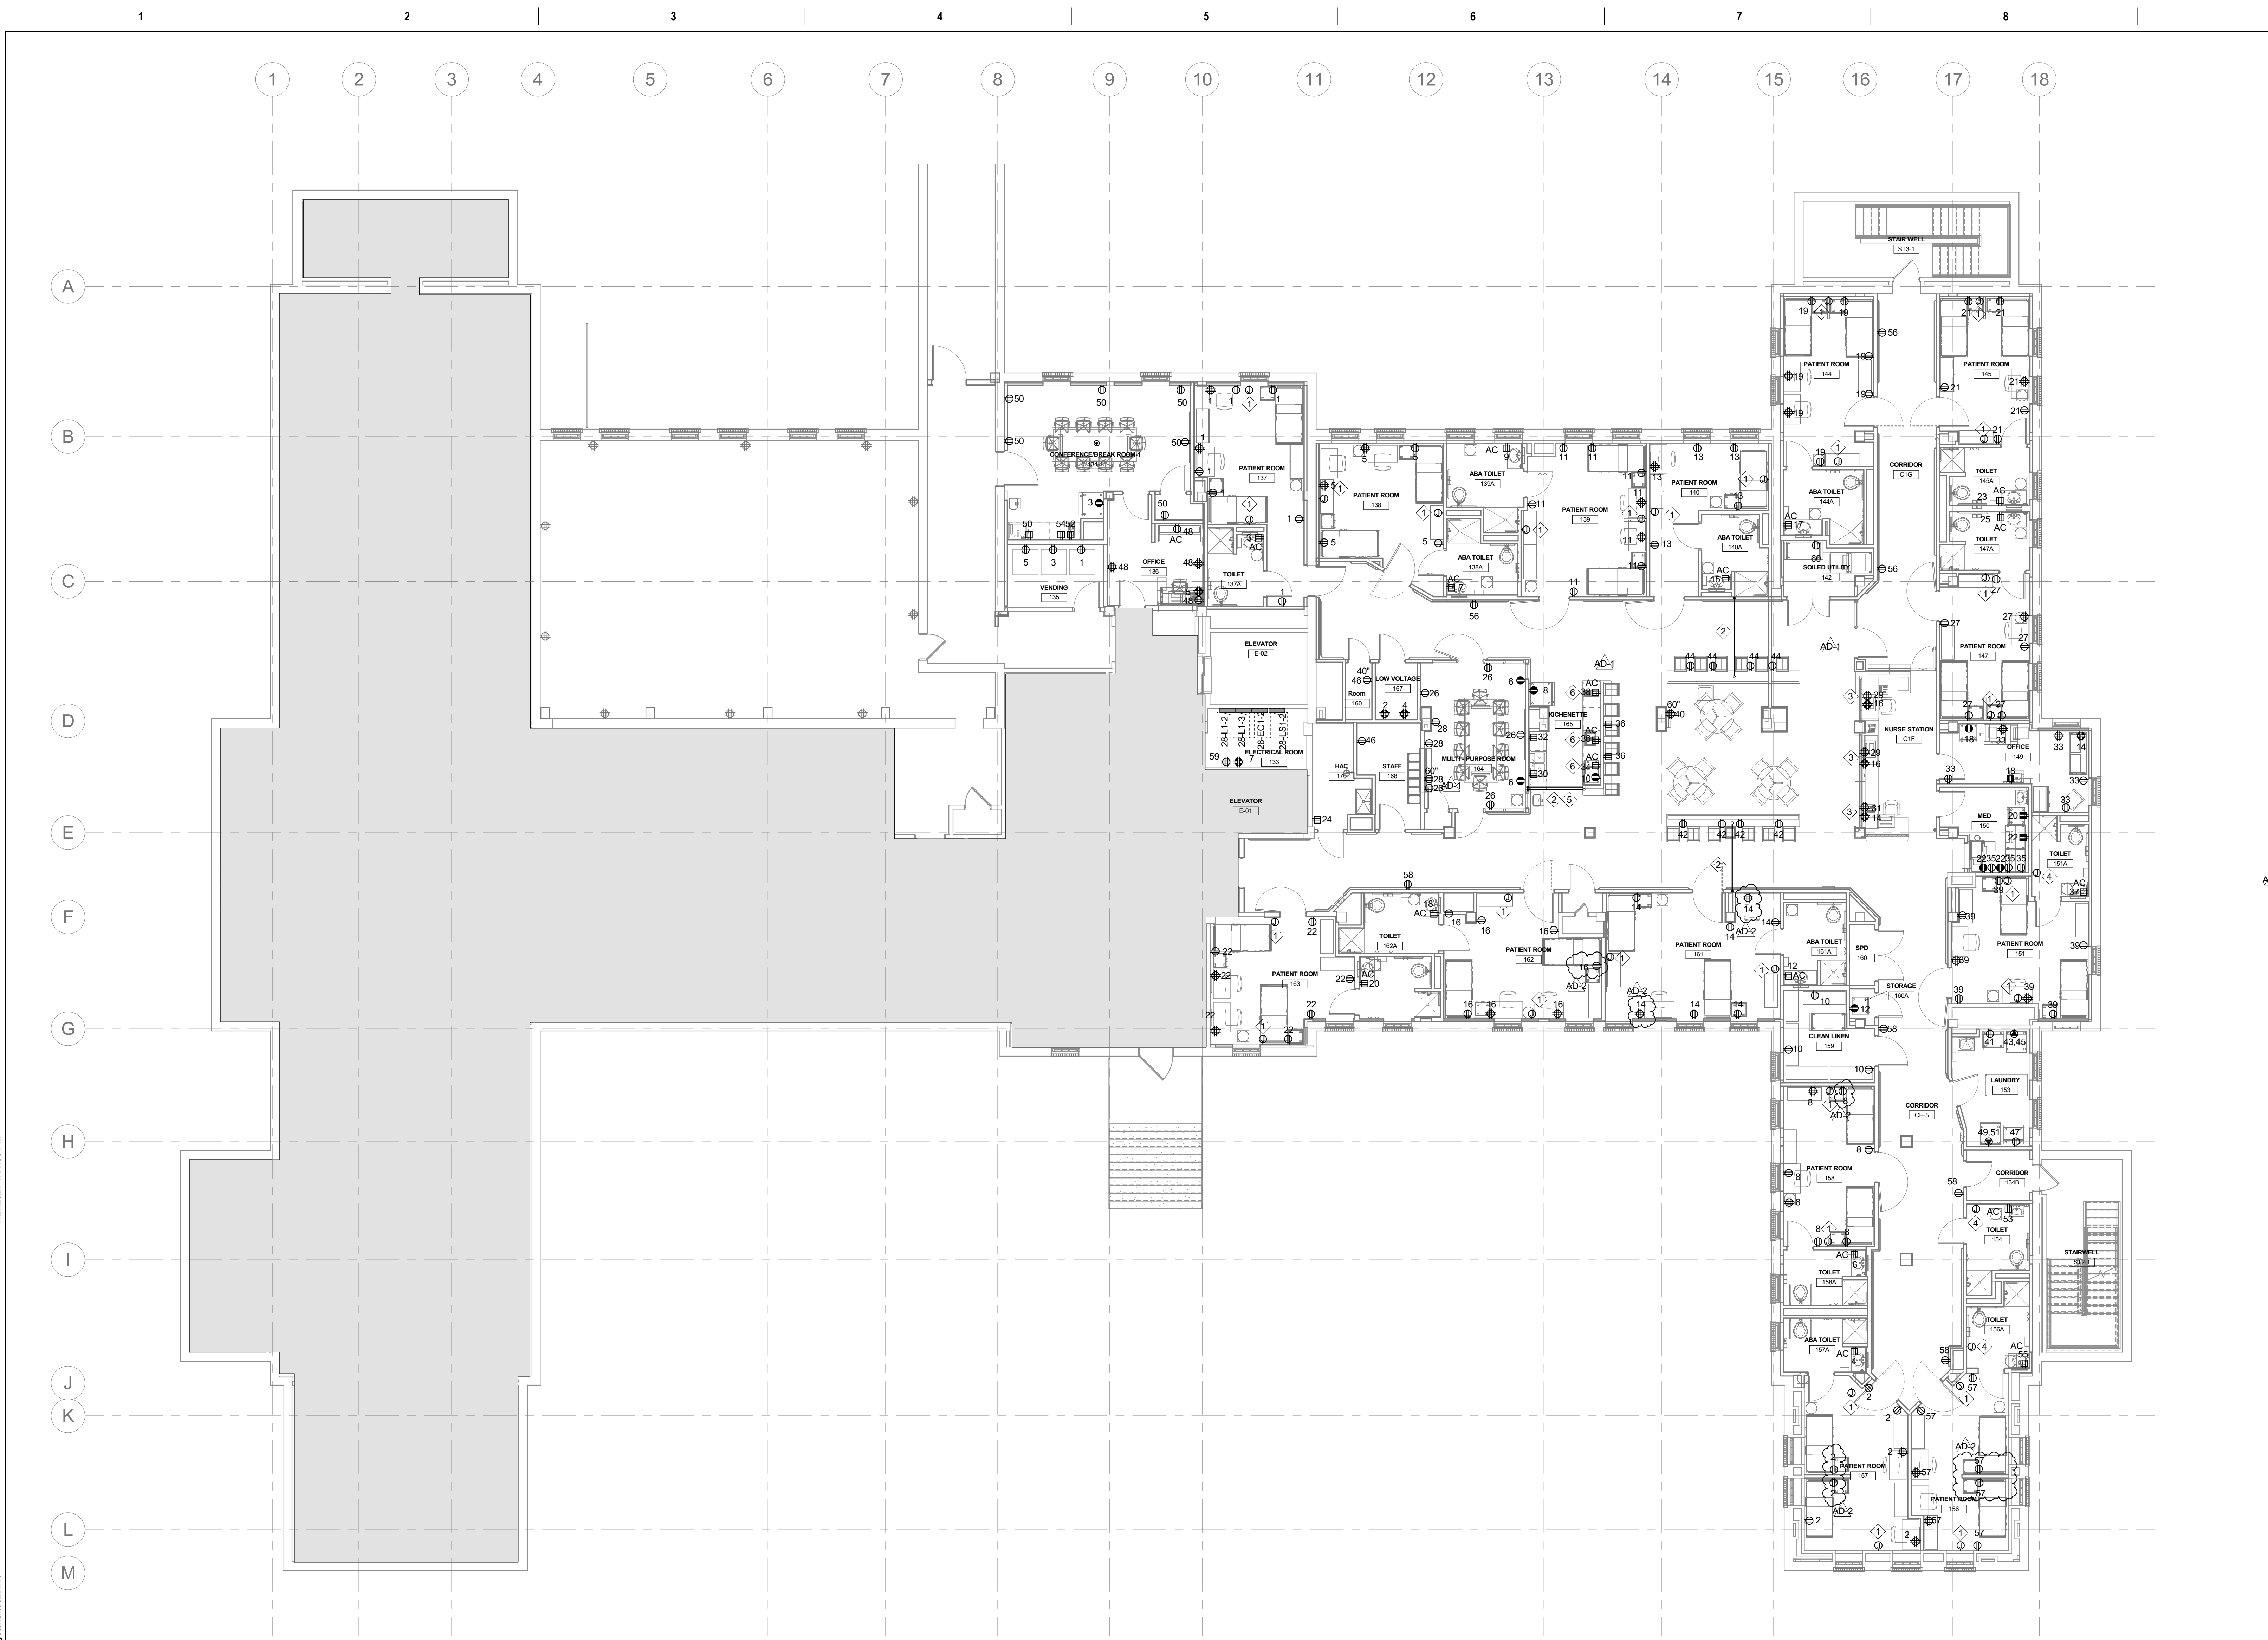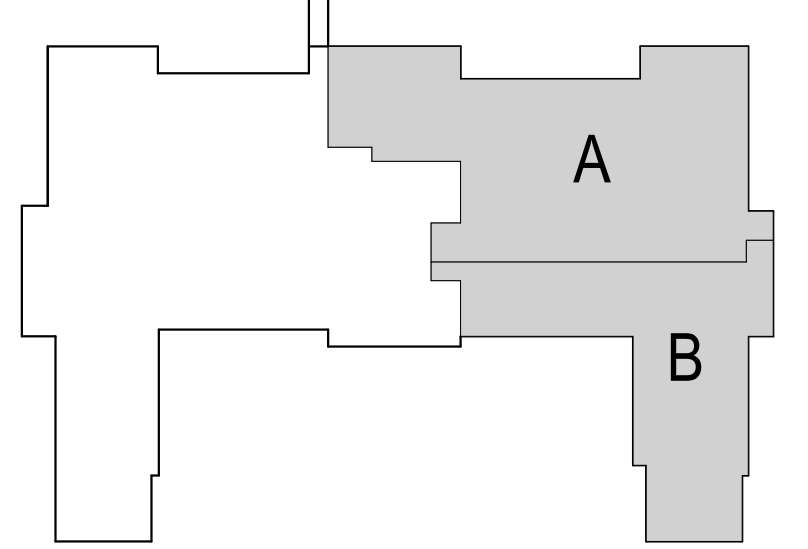

1 FIRST POWER FLOOR PLAN  
1/8" = 1'-0"

Revision#	Description	Date:
2	REVISION SET 2 (PREBID ADDENDUM)	07/23/2021
1	REVISION SET 1 (PREBID ADDENDUM)	06/15/2021

**CONSULTANT**

**DUNHAM**

50 South Sixth Street / Suite 1100  
Minneapolis, Minnesota 55402-1540  
PHONE 612.465.7550 FAX 612.465.7551  
WEB dunhameng.com  
mechanical + electrical consulting engineering  
022959-007-00

**ARCHITECT/ENGINEER OF RECORD**

**ANDERSON**

13605 1st Ave. N. #100 Plymouth, MN 55441  
P 763.412.4000 | F 763.412.4090 | ae-mn.com  
Anderson Engineering of Minnesota, LLC | Proj # Project Number

**STAMP**

I hereby certify that this plan, specification or report was prepared by me or under my direct supervision and that I am a duly licensed Professional Engineer under the laws of the State of Minnesota.

Name Curtis D. Barlage, P.E.  
Date 05/22/2020 Reg. No. 45914

Project Title RENOVATE BUILDING 28 FIRST FLOOR EAST RTFP			Project Number 656-19-306		
Location SAINT CLOUD, MN			Building Number 28		
Phase CONSTRUCTION DOCUMENTS			Drawing Number EP111		
Drawing Title FIRST POWER FLOOR PLAN			Issue Date MAY 22, 2020	Checked CB	Drawn BZ

**VA** U.S. Department of Veterans Affairs

Veterans Health Administration  
St. Cloud VA Health Care System



**GENERAL NOTES:**

- A. BUILDING WILL BE IN USE DURING CONSTRUCTION. SCHEDULE AND CARRY OUT THE WORK IN SUCH A MANNER AS TO CAUSE THE OWNER A MINIMUM OF INCONVENIENCE DUE TO SERVICE INTERRUPTION. TEMPORARY SERVICES (FEEDER, BRANCH CIRCUIT, AND SIGNAL SYSTEMS) SHALL BE INSTALLED IF ONE AREA OR PHASE OF CONSTRUCTION DISRUPTS SERVICE TO ANOTHER AREA OF THE BUILDING(S) OR IF THE EQUIPMENT, CONDUITS, OR FEEDERS HAVE TO BE RELOCATED TO ALLOW CONSTRUCTION TO PROGRESS. SERVICE INTERRUPTIONS SHALL BE CONFINED TO THE SMALLEST AREA POSSIBLE AT ANY ONE TIME AND INTERRUPTIONS SHALL BE SCHEDULED WITH THE OWNER'S SITE REPRESENTATIVE. THERE SHALL BE DESIGNATED AREAS WHERE INTERRUPTIONS LIMITED TO AND SHALL BE CONDUCTED AFTER HOURS (8:00 PM - 6:00 AM) MONDAY THROUGH SATURDAY. AFTER SERVICE HAS BEEN RESTORED FOLLOWING AN INTERRUPTION, INSPECT AREAS AFFECTED BY THE INTERRUPTION AND BE RESPONSIBLE FOR RETURNING AUTOMATICALLY CONTROLLED EQUIPMENT TO THE SAME OPERATING CONDITION WHICH EXISTED PRIOR TO THE INTERRUPTION.
- B. SIGNIFICANT NOISE PRODUCING WORK SHALL BE CONDUCTED AFTER HOURS (8:00 PM - 6:00 AM) AND WEEKENDS.
- C. DO NOT REUSE EXISTING WIRING. PROVIDE NEW HOME RUNS UNLESS NOTED OTHERWISE. PROVIDE DEDICATED NEUTRALS AS REQUIRED BY THE NEC. HANDLE TIES OR MULTI POLE BREAKERS FOR SINGLE PHASE LOADS ARE UNACCEPTABLE.
- D. COORDINATE LOCATION AND INSTALLATION OF CEILING MOUNTED EQUIPMENT WITH THE VA PRIOR TO ROUGH-IN.
- E. INSTALL MINIMUM #10 AWG FOR ALL 120V CIRCUIT HOMERUNS IN EXCESS OF 75'.
- F. ROUTE CONDUITS IN A MANNER TO CONCEAL WHERE POSSIBLE.
- G. DEVICES SHOWN BACK-TO-BACK ARE FOR INTENT PURPOSES ONLY. DO NOT INSTALL BACK-TO-BACK TO PREVENT NOISE TRAVEL. SEE SPECIFICATIONS FOR ADDITIONAL INFORMATION.
- H. ALL FURNITURE LAYOUTS ARE SHOWN FOR DESIGN INTENT ONLY. FINAL LOCATIONS OF FURNITURE AND ASSOCIATED POWER/DATA OUTLETS TO BE COORDINATED WITH OWNER.
- I. ROUTE LOW VOLTAGE CABLING TO DATA ROOM AS INDICATED ON DRAWINGS. PROVIDE CABLE COUNT AS INDICATED. ROUTE VOICE/DATA CABLING IN INDICATED CABLE TRAYS. CABLING NOT IN CABLE TRAY SHALL BE INSTALLED IN CONDUIT.
- J. PROVIDE A DOUBLE GANG BOX WITH A SINGLE GANG MUDRING AND (1) 3/4" CONDUIT ROUTED TO ADJACENT CABLE TRAY FOR LOW VOLTAGE ROUGH-IN.
- K. COORDINATE COMMUNICATION DEVICES NEXT TO RECEPTACLE DEVICES SUCH THAT THE DEVICES ARE MOUNTED NEXT TO EACH OTHER.
- L. INSTALL SMOKE DETECTORS A MINIMUM OF 3' FROM SUPPLY DIFFUSERS.
- M. COORDINATE DURESS BUTTON WALL-MOUNTED LOCATION WITH THE CONTRACTING OFFICER REPRESENTATIVE(COR) PRIOR TO ROUGH-IN.

**KEY NOTES:**

- 1. PROVIDE INTEGRATED DOOR MOUNTED STAND-ALONE BATTERY OPERATED CARD READER AT EACH DOOR LOCATION SHOWN THAT CONNECT VIA WIRELESS COMMUNICATION TO CARD ACCESS SYSTEM IN LOW VOLTAGE EQUIPMENT ROOM.
- 2. PROVIDE ONE (1) RG-6U COAXIAL CABLE, F-TYPE CONNECTOR AND TELEVISION LCD MONITOR AT TV OUTLET TO LOCATION SHOWN. ELECTRICAL CONTRACTOR TO PROVIDE 3/4" CONDUIT TO CABLE TRAY FROM DEVICE. EXTEND RG-6 CABLE TO CATV CONNECTION POINT IN ROOM 72 (ACCESS HATCH IN TUNNEL). PROVIDE SPLITTERS AND TAPS.
- 3. PROVIDE LOW AUDIOVISUAL OUTLET WITH HDMI, VGA, C-VIDEO, AUDIO L/R CABLES ROUTED TO TV OUTLET FOR CONNECTION OF OWNER EQUIPMENT TO TV MONITOR. ELECTRICAL CONTRACTOR TO PROVIDE (2) 1" CONDUITS TO CABLE TRAY FROM DEVICE.
- 4. PROVIDE RAU/LND RESPONDER 5000 NURSE CALL PANEL. PROVIDE BACKBONE CABLING TO NURSE CALL HEAD END ON SECOND FLOOR. PROVIDE PROGRAMMING TO INTEGRATE NEW DEVICES INTO EXISTING SYSTEM.
- 5. PROVIDE SECURITY PANEL. PROVIDE BACKBONE CABLING TO SECURITY HEAD END IN EXISTING FIRST FLOOR DATA ROOM. PROVIDE PROGRAMMING TO INTEGRATE NEW DEVICE INTO EXISTING SYSTEM. PROVIDE DVR WITH 500GB STORAGE.
- 6. PROVIDE (3) THREE CONDUIT SLEEVES UP TO SECOND LEVEL IT ROOM.
- 7. PROVIDE (3) 3" CONDUITS FOR IT CABLE PATHWAY TO SECOND FLOOR IT ROOM.
- 8. EXISTING PA SYSTEM AMPLIFIER. EXTEND TO ALL NEW SPEAKERS.
- 9. EXISTING SECURITY SYSTEM HEAD END. EXPAND AND EXTEND TO NEW PANEL.
- 10. MOUNT DEVICES TO OWNER PROVIDED FURNITURE.
- 11. PRIMARY MASTER STATION FOR FIRST FLOOR NURSE CALL DEVICES. DEVICES SHALL ALSO REPORT TO SECOND FLOOR, EAST SIDE NURSE STATION.

**KEY PLAN**

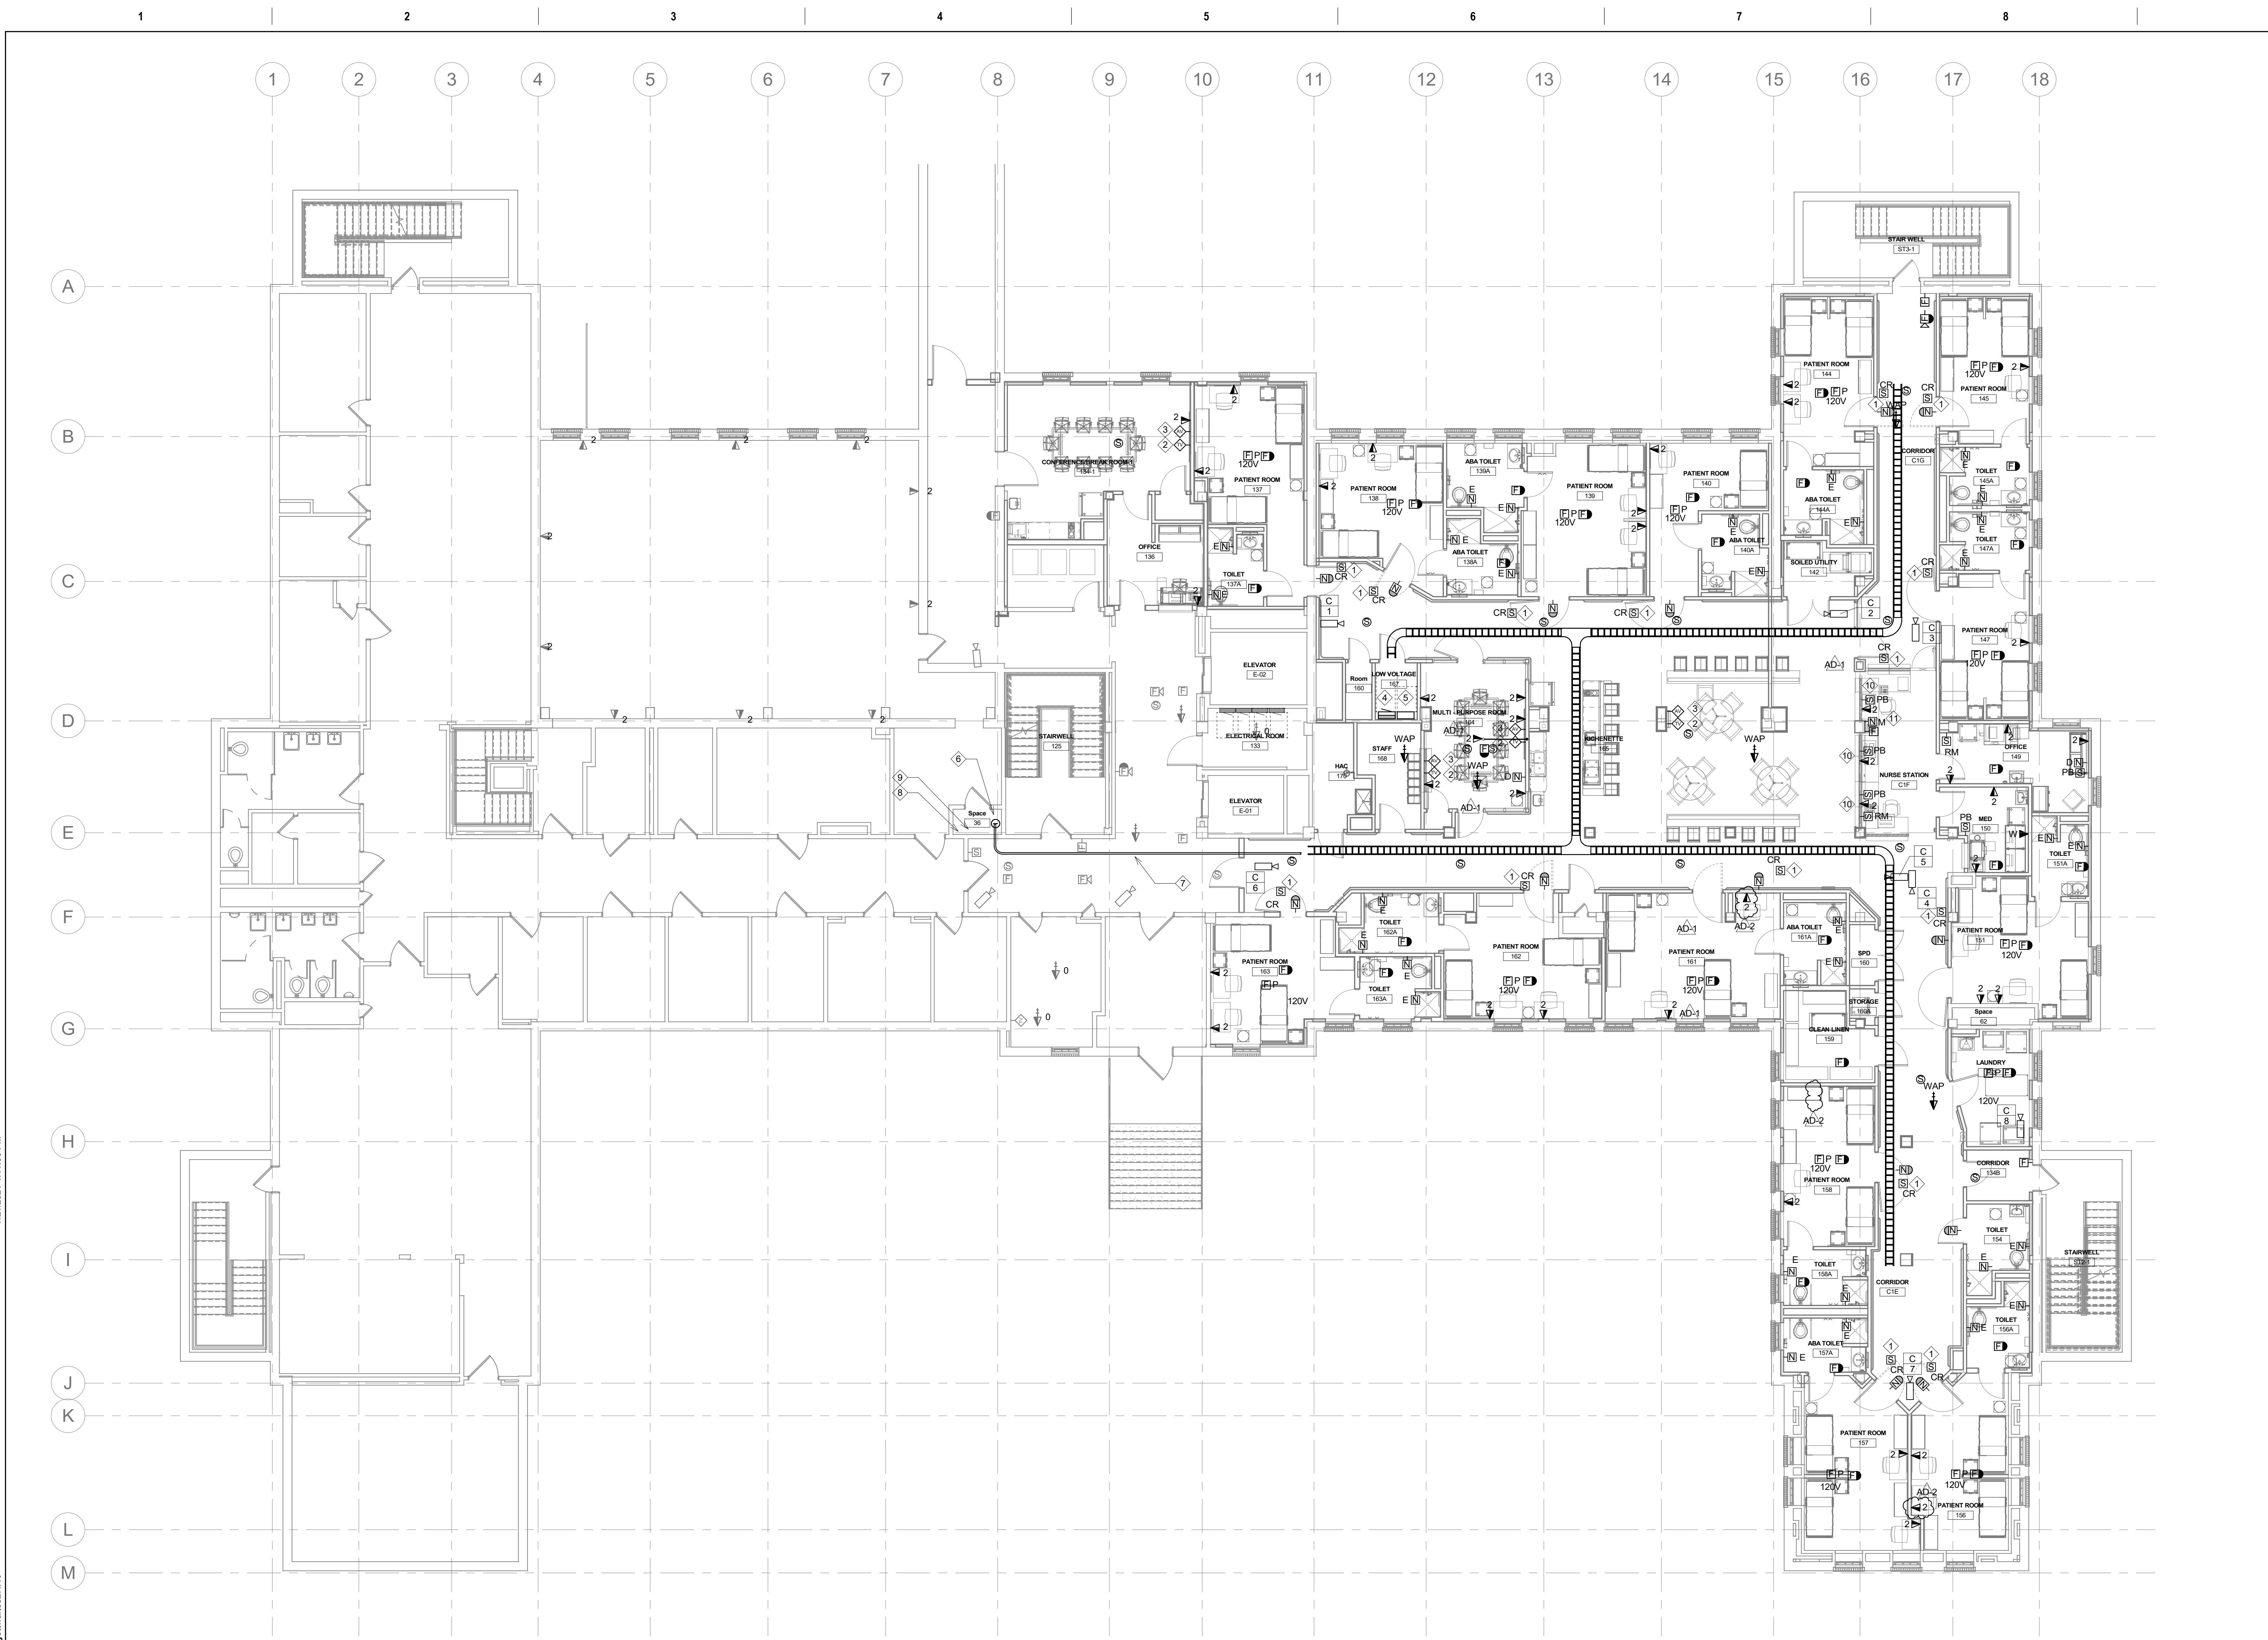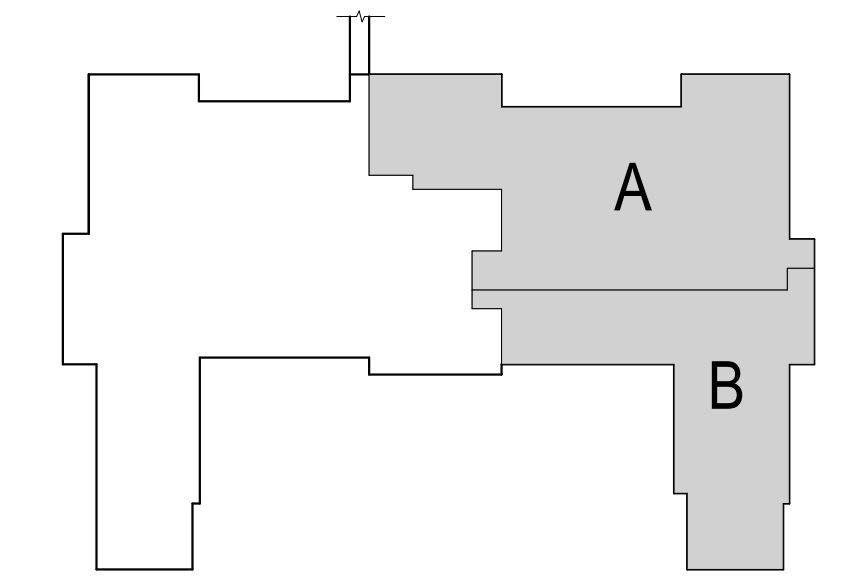

1 FIRST SYSTEMS FLOOR PLAN  
1/8" = 1'-0"

Revision#	Description	Date
2	REVISION SET 2 (PREBID ADDENDUM)	07/23/2021
1	REVISION SET 1 (PREBID ADDENDUM)	06/15/2021

**CONSULTANT**

**DUNHAM**

50 South Sixth Street / Suite 1100  
Minneapolis, Minnesota 55402-1540  
PHONE: 612.465.7550 FAX: 612.465.7551  
WEB: dunhameng.com  
mechanical + electrical consulting engineering  
052959-007-00

**ARCHITECT/ENGINEER OF RECORD**

**ANDERSON**

13605 1st Ave. N. #100 Plymouth, MN 55441  
P 763.412.4000 | F 763.412.4090 | ae-mn.com  
Anderson Engineering of Minnesota, LLC | Proj # Project Number

**STAMP**

I hereby certify that this plan, specification or report was prepared by me or under my direct supervision and that I am a duly licensed Professional Engineer under the laws of the State of Minnesota.

Name: Curtis D. Barlage, P.E.  
Date: 05/22/2020 Reg. No. 45914

**Project Title**  
RENOVATE BUILDING 28  
FIRST FLOOR EAST RTPT

**Location**  
SAINT CLOUD, MN

**Phase**  
CONSTRUCTION DOCUMENTS

**Drawing Title**  
FIRST SYSTEMS FLOOR PLAN

**Issue Date**  
MAY 22, 2020

**Checked**  
CB

**Drawn**  
BZ

**Project Number**  
656-19-306

**Building Number**  
28

**Drawing Number**  
ES111

**VA**

**U.S. Department of Veterans Affairs**

Veterans Health Administration  
St. Cloud VA Health Care System