

54



189 - sleeves thru walls
Total = 189


189



FARGO VAHCS
2101 ELM STR
FARGO, ND 58

Drawing Title
BASE FLOOR
Basement Layout
01/10/2023


151

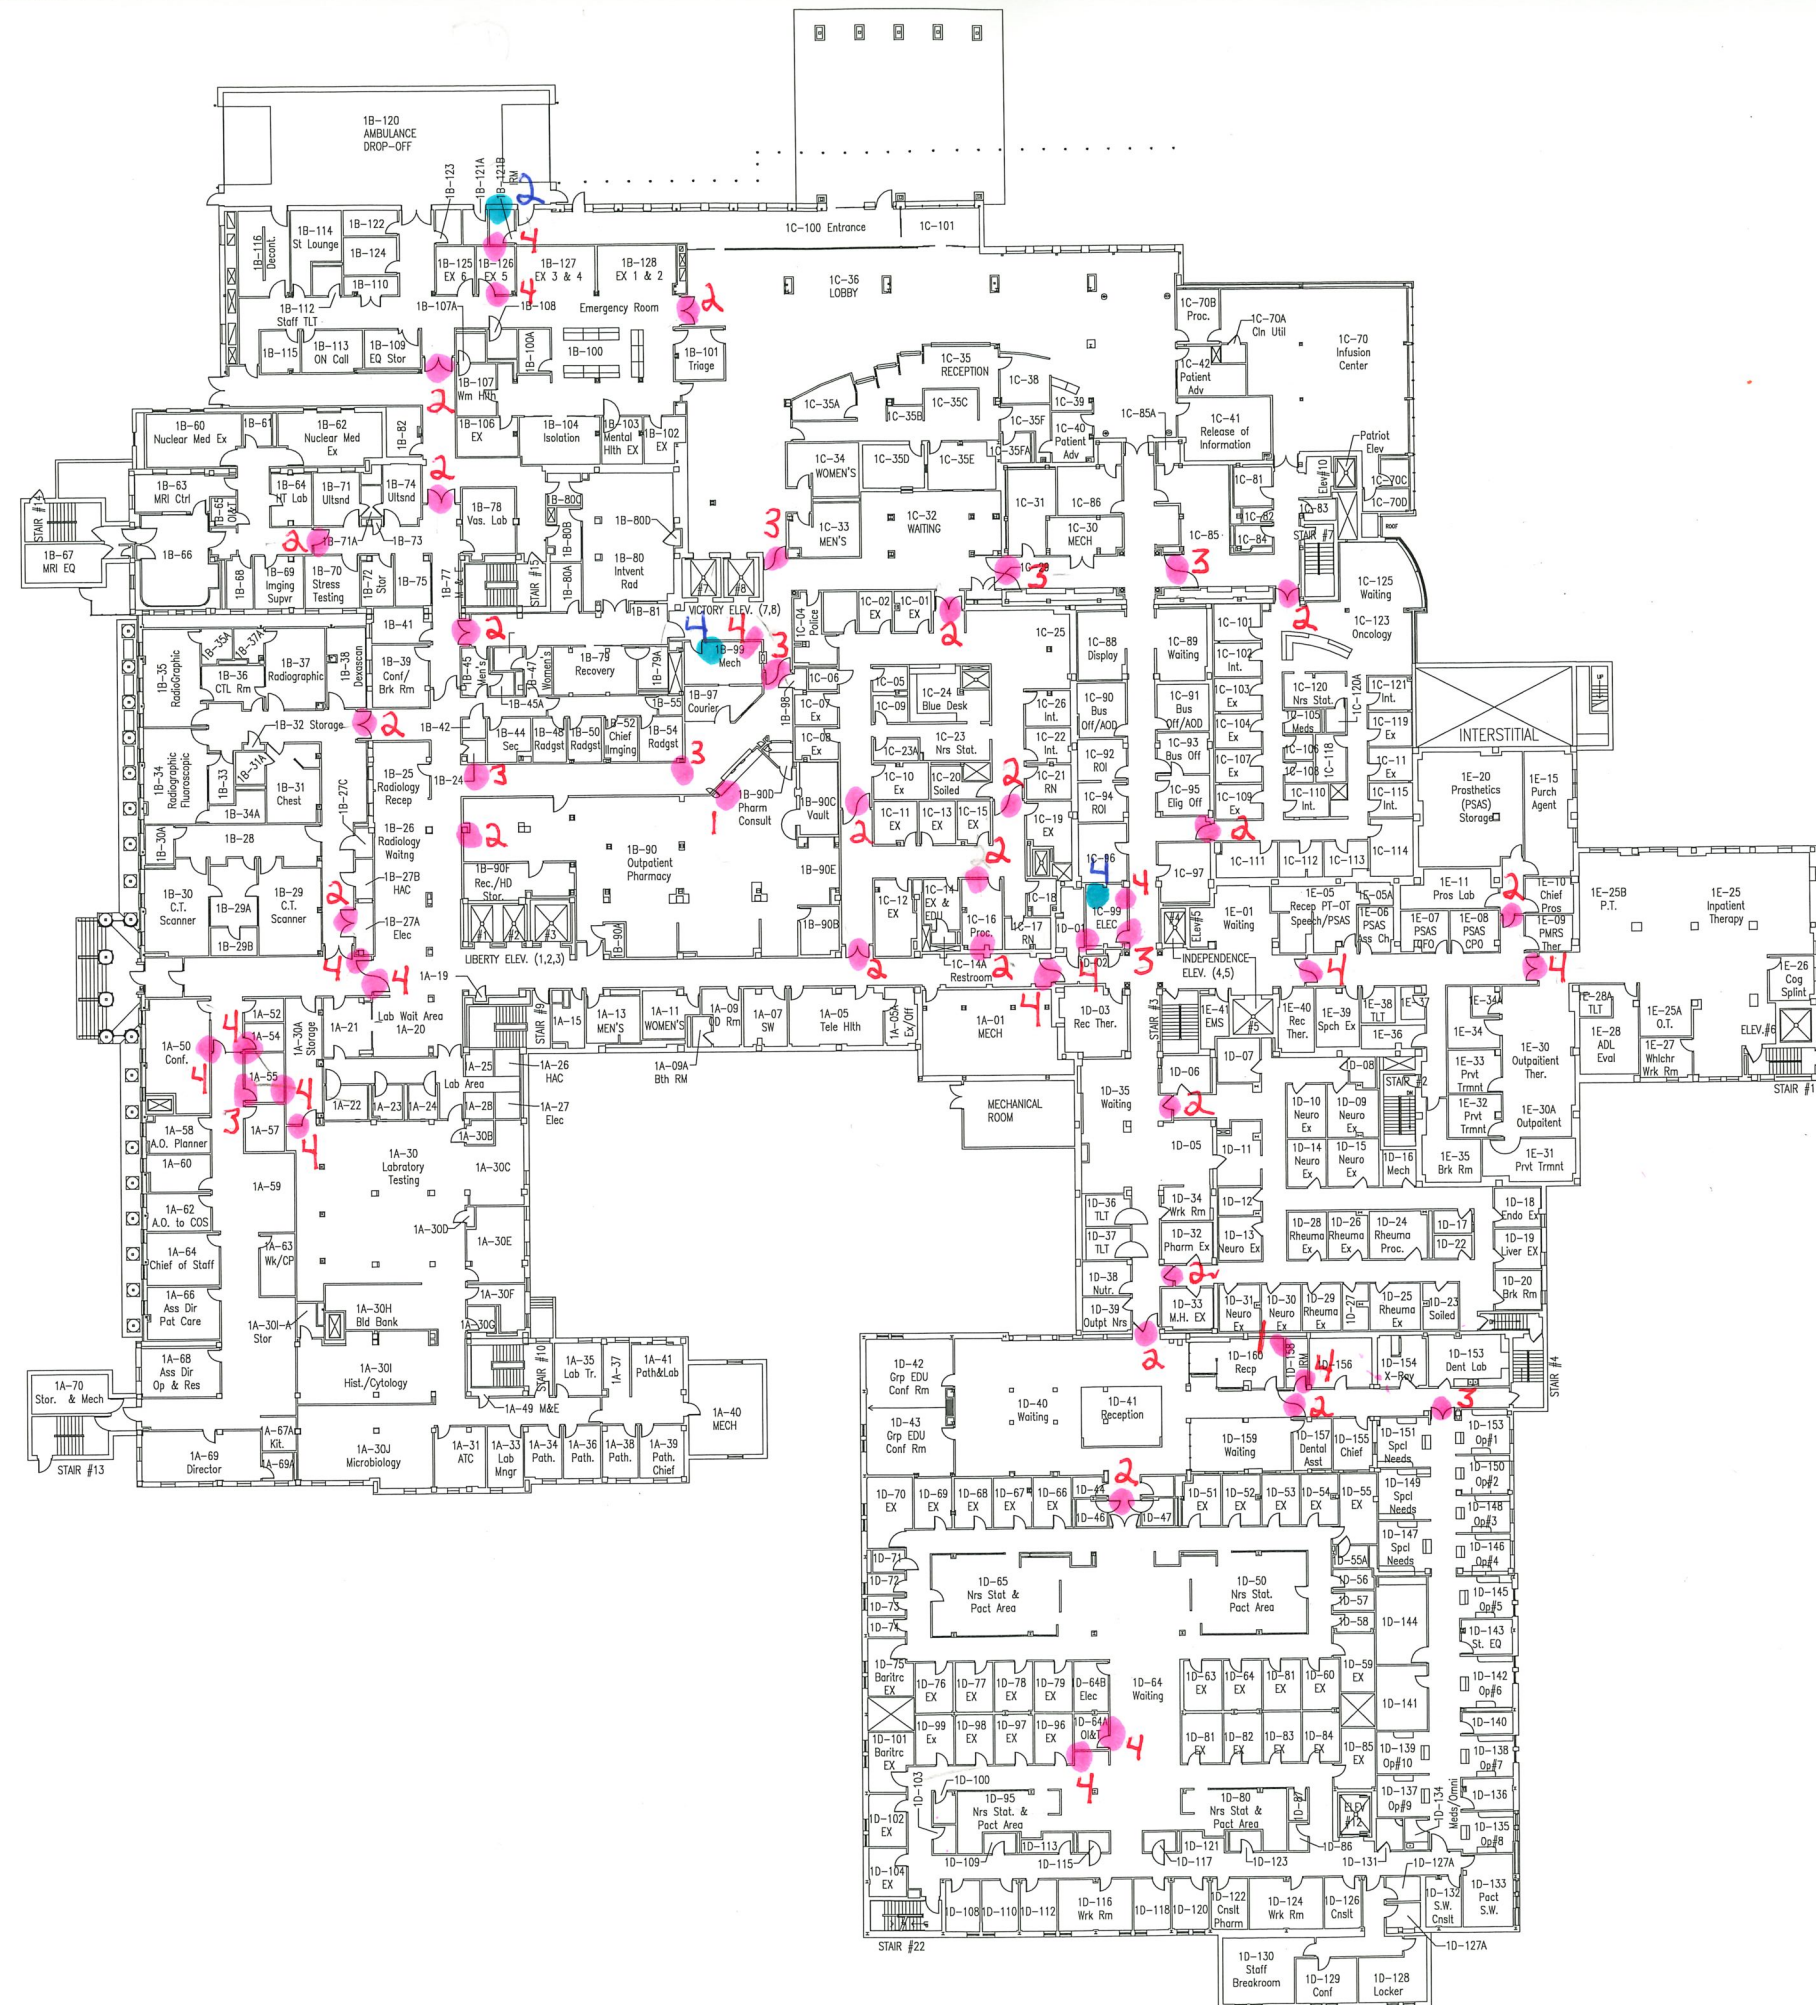

FARGO VAHCS
2101 ELM ST
FARGO, ND 58

Drawing Title

FIRST FLOOR
First Floor Layout
1/10/2023

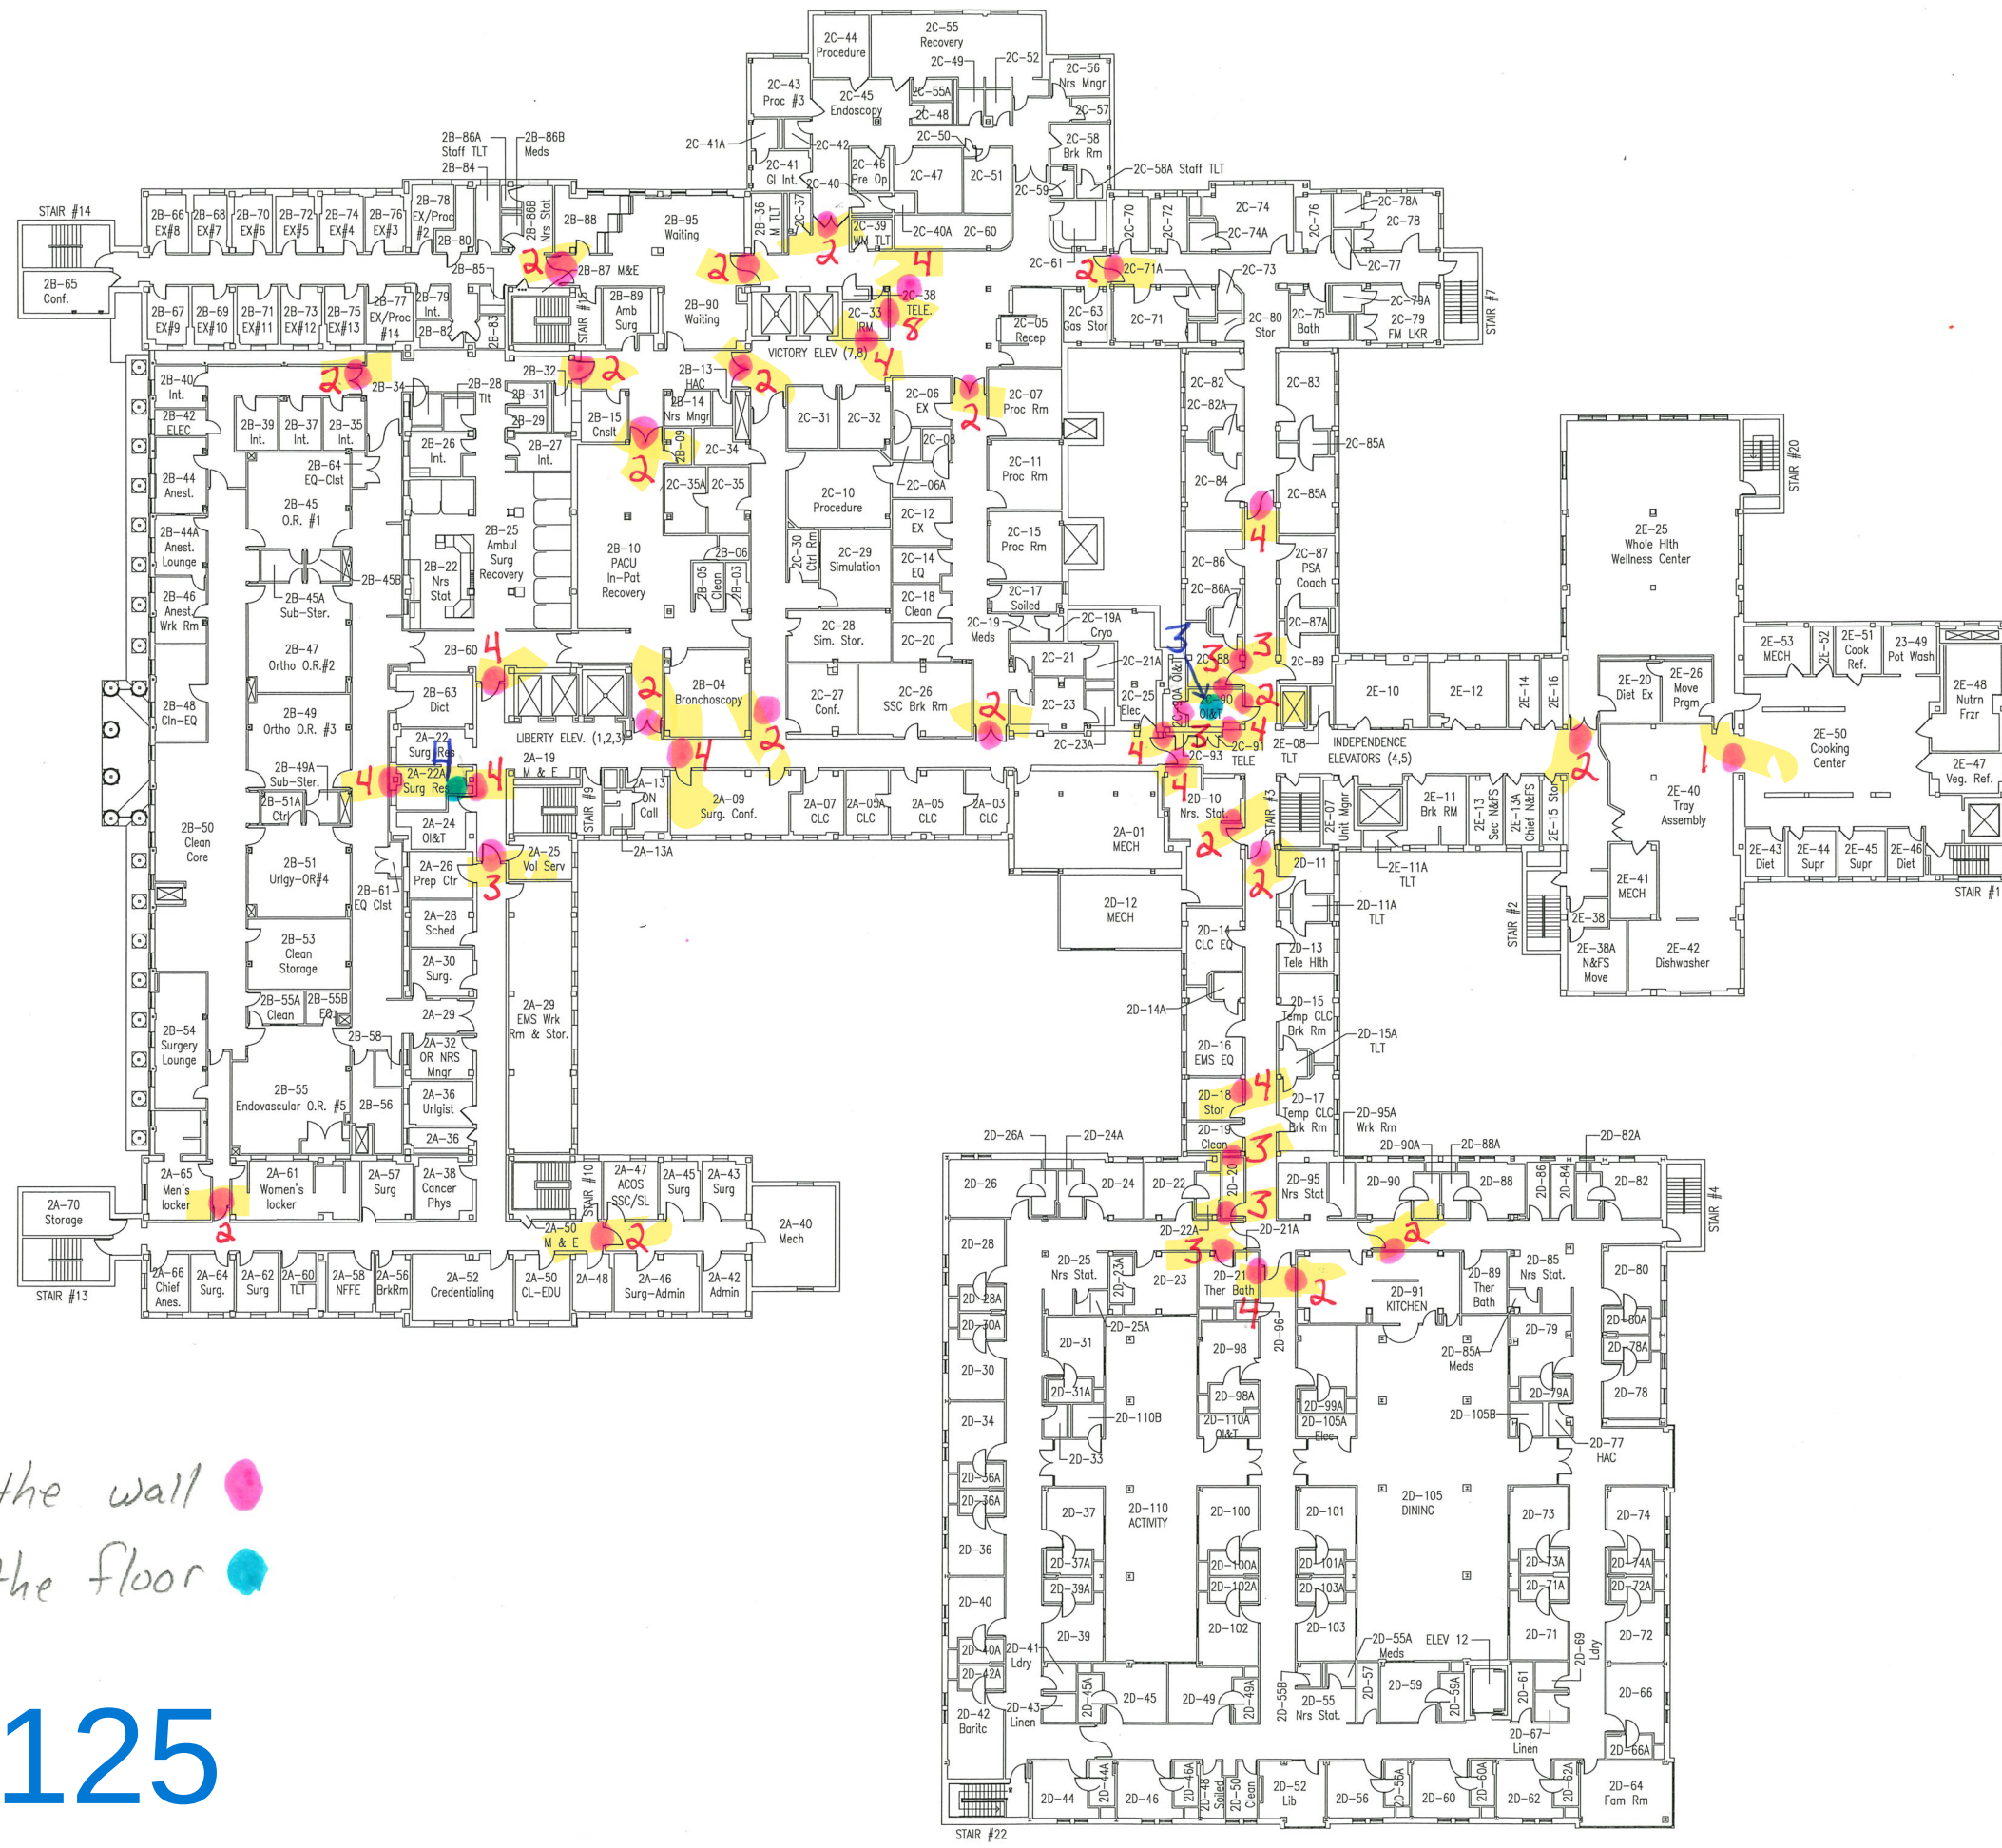

118 - thru the wall ●
 7 - thru the floor ●

Total = 125


125




FARGO VAHCS
 2101 ELM STR
 FARGO, ND 58

Drawing Title

SECOND FLOOR
 Second Floor Layout
 1/10/2023

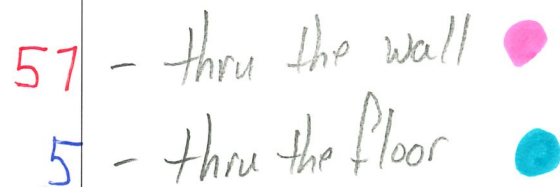

62

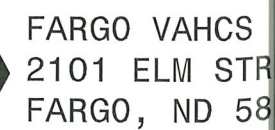


Drawing Title

FOURTH FLOOR
Fourth Floor Layout
1/10/2023

32 - wall sleepers
 4 - floor sleepers
 Total = 36

36

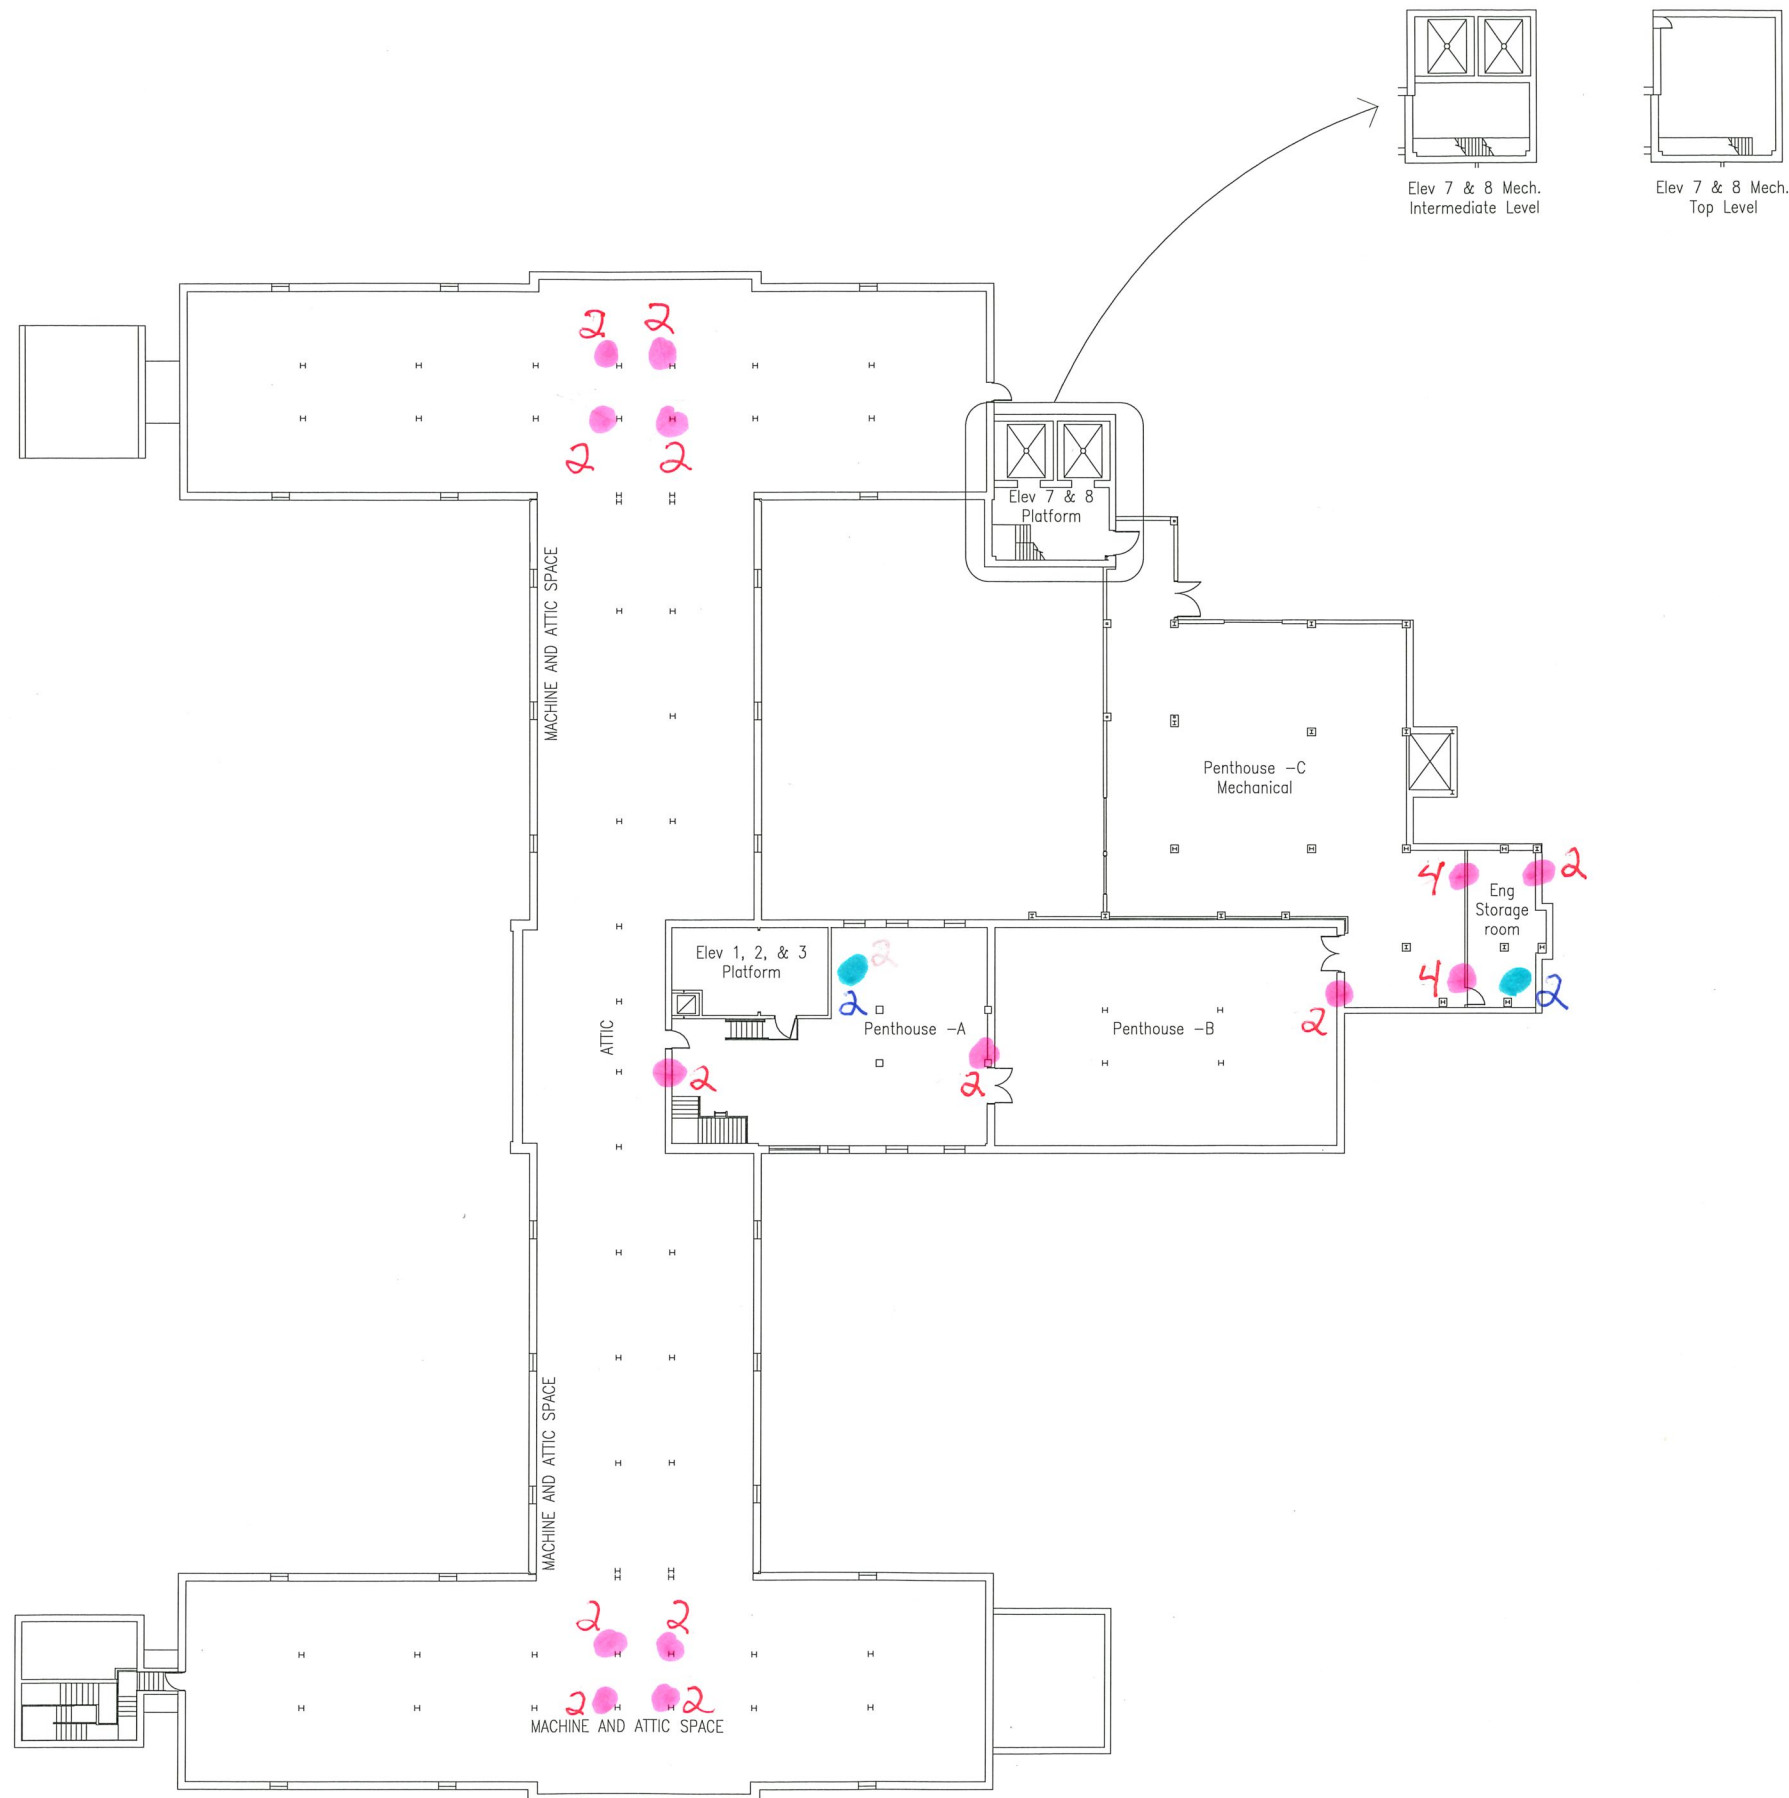

FARGO VAHCS
 2101 ELM STR
 FARGO, ND 58

Drawing Title

PENTHOUSE/ATTIC
 Penthouse Layout
 1/10/2023