




4242 Delaware Street
 Denver, CO 80216
PH:(303) 750-6500
FX:(303) 750-6400

www.beaconcom.com

Key Plan:

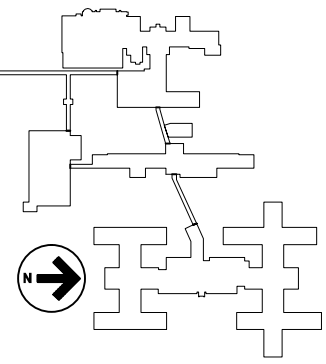

VA BLACK HILLS HEALTH CARE SYSTEM FORT MEADE CAMPUS

113 COMANCHE ROAD
 FORT MEADE, SD 57741

**RESPONDER 4000 NURSE CALL SYSTEM
 WITH CODE BLUE INTEGRATION
 TO WIRELESS PHONES, POCKET PAGERS
 AND OVERHEAD PAGING SYSTEMS**

**INSTALLATION BY:
 BEACON COMMUNICATIONS, LLC
 4242 DELAWARE STREET
 DENVER, COLORADO 80216
 303-750-6500**

**VA BLACK HILLS
 FORT MEADE CAMPUS
 R4000 NURSE CALL SYSTEM
 FORT MEADE, SD
 COVER PAGE**

Job No. 130026

BY: DATE:
 Drawn: JZ 05-09-13
 Checked: --
 Approved: --
 Original Issue: --

ISSUE RECORD:		
No:	Date:	Description:
1	06-10-13	SUBMITTAL
2	02-05-14	ADDED NC-5.00
3	03-12-14	AS-BUILT

DRAWING INDEX:

NC-0.00	COVER PAGE
NC-0.01	SITE PLAN & SYMBOL LEGEND
NC-1.00	BLDG 113 FLOOR 1 NURSE CALL - SPECIALTY & CLINICAL SCVS.
NC-1.01	BLDG 113 FLOOR 1 NURSE CALL - RESPIRATORY THERAPY
NC-1.02	BLDG 145 FLOOR 2 NURSE CALL - CARDIAC SERVICES
NC-1.03	BLDGS 148 & 113, ROOM G147, ROOM E146, ROOM G234
NC-5.00	INTEGRATION ONE-LINE DIAGRAM
NC-6.00	NURSE CALL ENCLOSURE DETAILS
NC-6.01	TYPICAL NURSE CALL CONNECTIONS
NC-6.02	NURSE CALL TYPICAL INFO

Sheet:
 COVER PAGE


NC-0.00



4242 Delaware Street
 Denver, CO 80216
 PH:(303) 750-6500
 FX:(303) 750-6400

www.beaconcom.com

Key Plan:


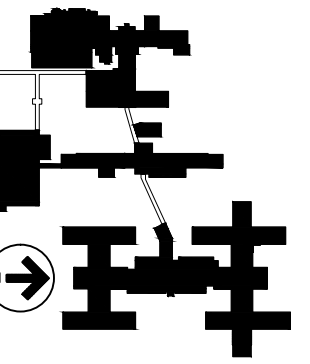


**VA BLACK HILLS
 FORT MEADE CAMPUS
 R4000 NURSE CALL SYSTEM
 FORT MEADE, SD**
 SITE PLAN & SYMBOL LEGEND

Job No. 130026

BY: DATE:
 Drawn: JZ 05-09-13
 Checked: - -
 Approved: - -
 Original Issue: - -

ISSUE RECORD:
 No: Date: Description:
 1 06-10-13 SUBMITTAL

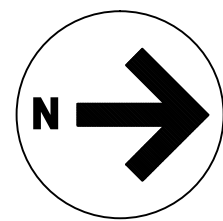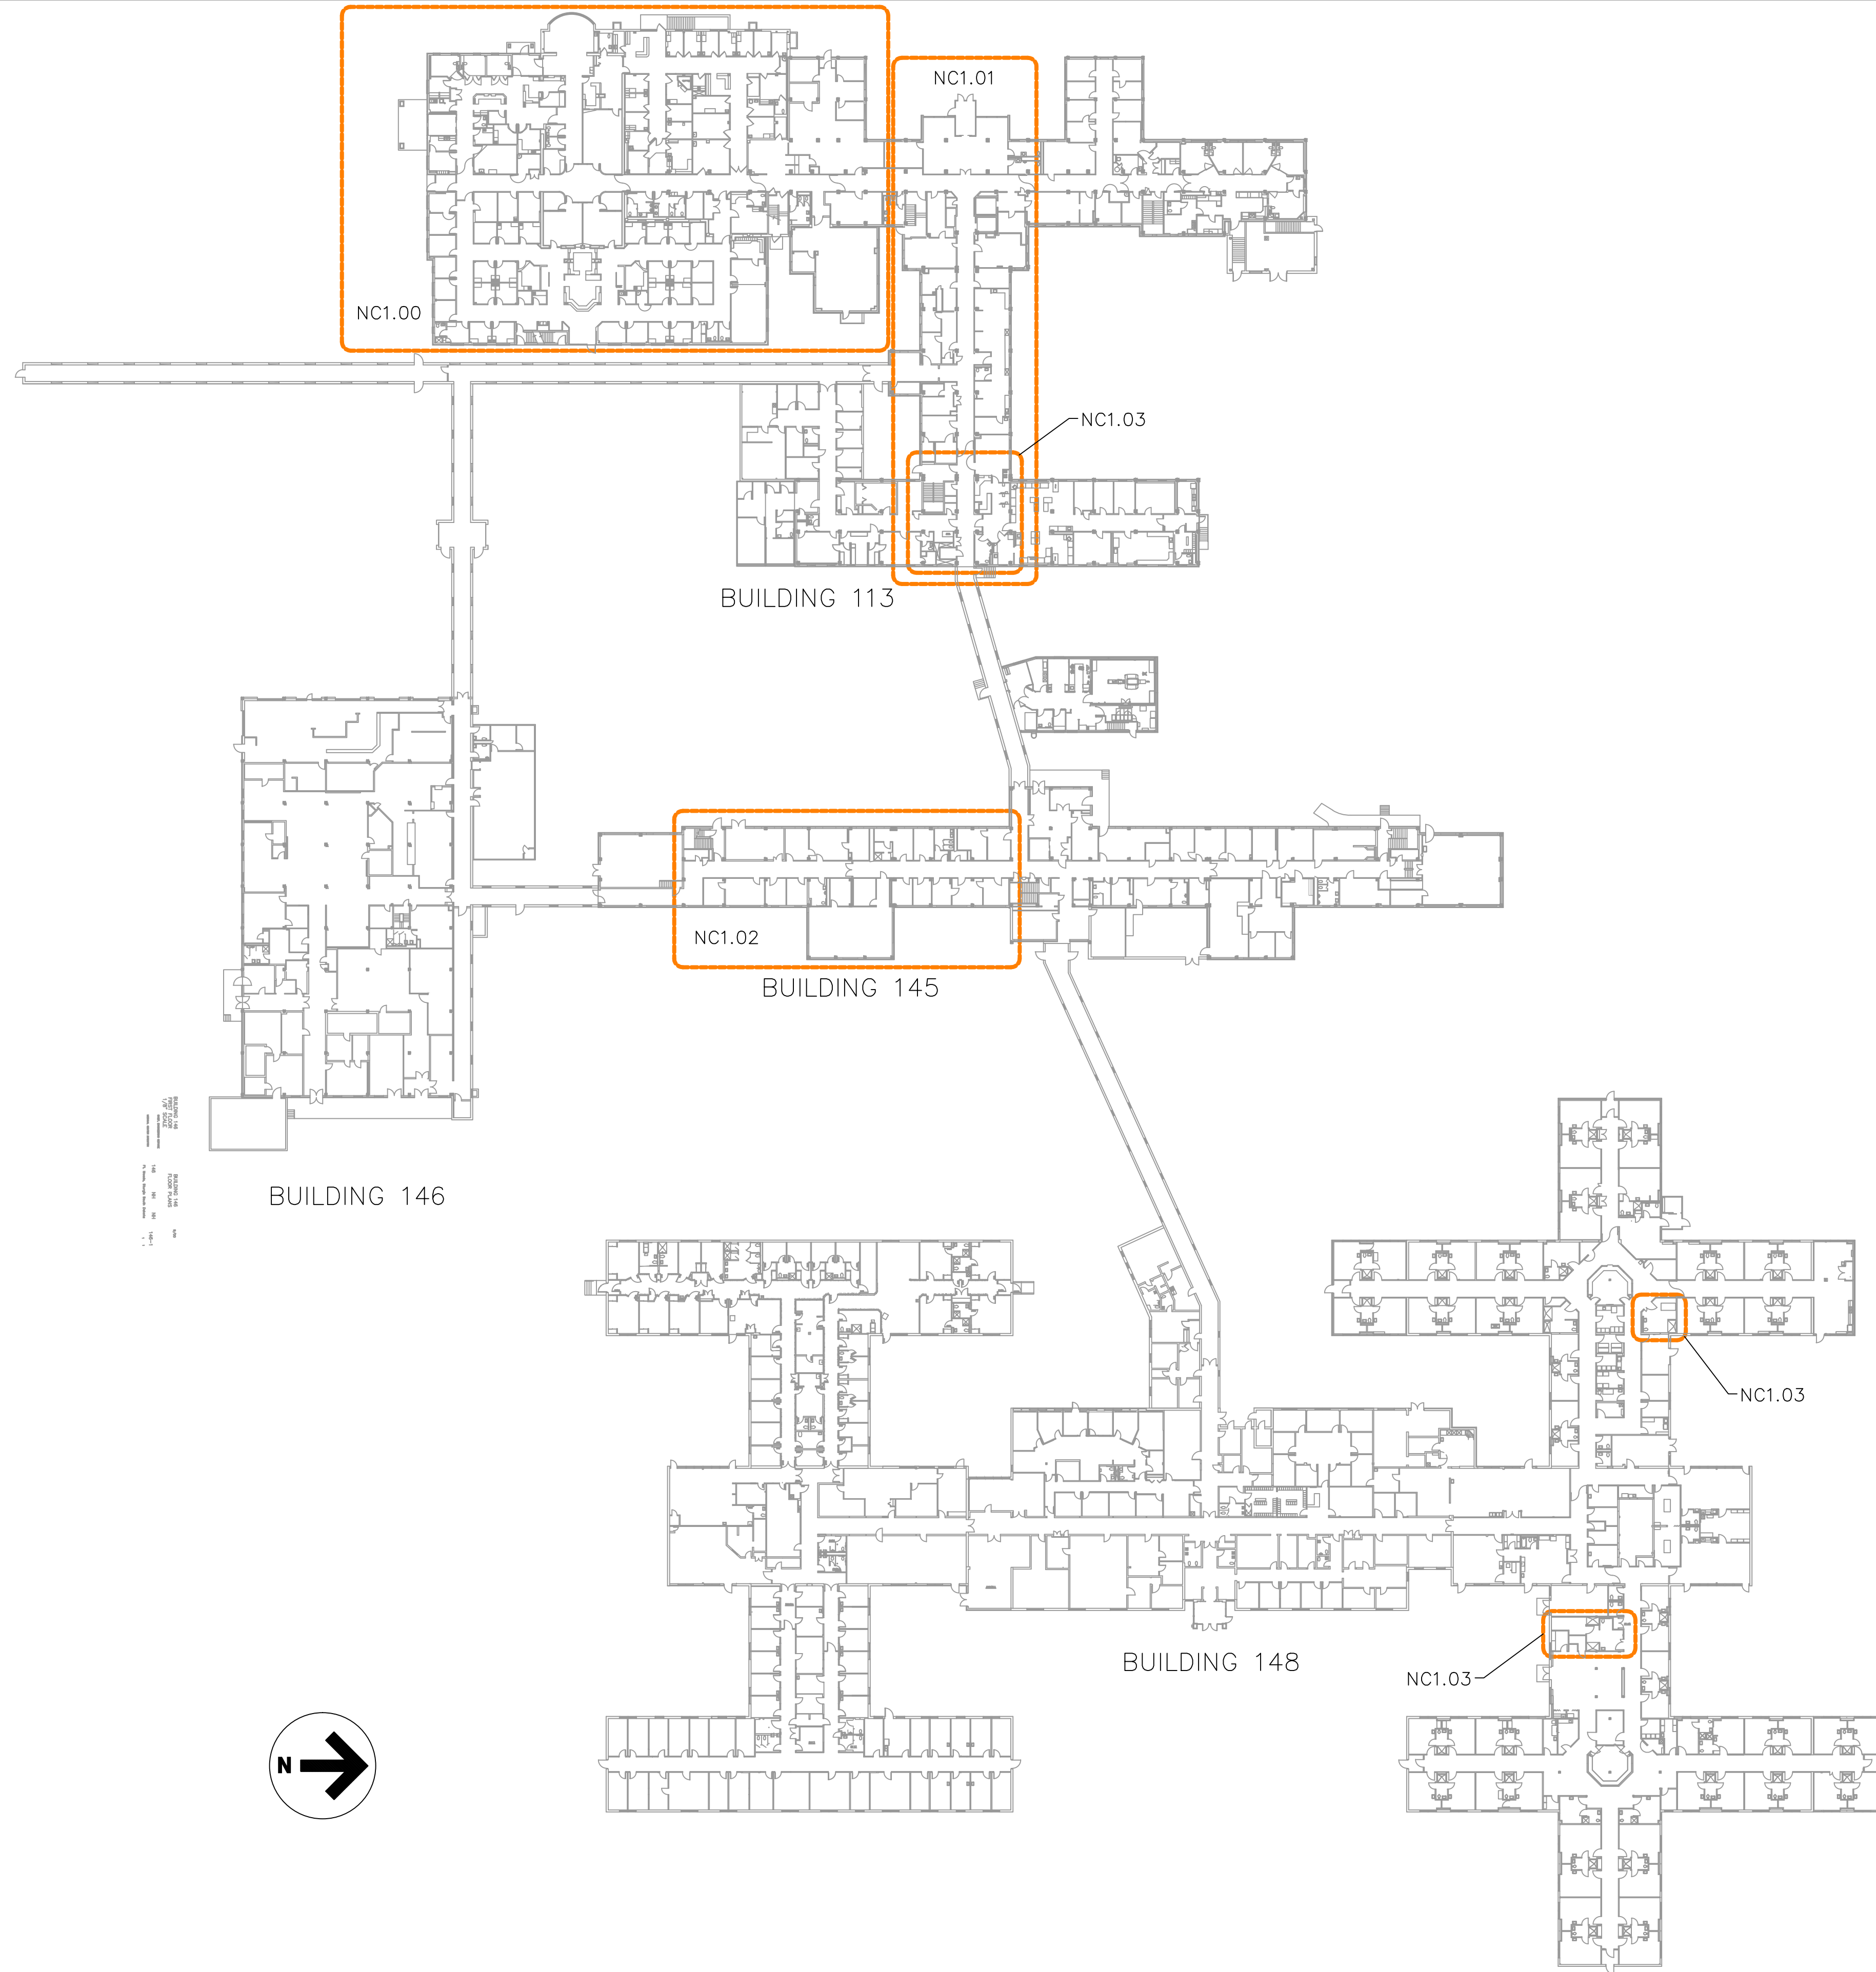

NURSE CALL RESPONDER R4000 SYMBOL LEGEND					
SYMBOL	MANUF.	PART #	DESCRIPTION	BACKBOX	BOX MOUNTING LOCATION
HEC	RAULAND	NC2828	NURSE CALL TERMINAL WITH GROUP CONTROL MODULE & POWER SUPPLIES	NC2828	54" A.F.F.
LCD	RAULAND	R4K4020	NURSE CONSOLE	SINGLE GANG BACKBOX W/ 1 GANG RING	OUTLET
SS	RAULAND	R4KSS	STAFF STATION	SINGLE GANG BACKBOX W/ 1 GANG RING	44" A.F.F.
D	RAULAND	R4KY2	DUTY STATION	SINGLE GANG BACKBOX W/ 1 GANG RING	44" A.F.F.
SP	RAULAND	R4K17V	SINGLE PATIENT STATION W/PILLOW SPEAKER	SINGLE GANG BACKBOX W/ 1 GANG RING	44" A.F.F.
EP	RAULAND	R4KPC11 R4KPC12	TOILET & SHOWER EMERGENCY STATION	SINGLE GANG BACKBOX W/ 1 GANG RING	44" A.F.F.
2B	RAULAND	R4KPB23	DUAL PUSH BUTTON STATION STAFF ASSIST / CODE	SINGLE GANG BACKBOX W/ 1 GANG RING	44" A.F.F.
4B	RAULAND	R4KPB44	FOUR-BUTTON STATION DESCRIPTION	SINGLE GANG BACKBOX W/ 1 GANG RING	44" A.F.F.
D	RAULAND	CLA244	CORRIDOR DOME	DUAL GANG DEEP BACKBOX W/ 1 GANG RING	CEILING
D	RAULAND	CLV144	CORRIDOR DOME	DUAL GANG DEEP BACKBOX W/ 1 GANG RING	CEILING
Z	RAULAND	CLA2V1D4	DUTY CORRIDOR LIGHT	DUAL GANG DEEP BACKBOX W/ 1 GANG RING	CEILING
PCA	RAULAND	DCA214D	DUTY DOMELESS CONTROLLER	N/A UNIT COMES IN A SUPPLIED ENCLOSURE	ABOVE CEILING USUALLY IN CORRIDOR
PCA	RAULAND	DCA200	AUDIO DOMELESS CONTROLLER	N/A UNIT COMES IN A SUPPLIED ENCLOSURE	ABOVE CEILING USUALLY IN CORRIDOR
CLAR4	RAULAND	CLAR4	AUDIO RELAY	N/A LOCATED IN THE DOME BACKBOX	
ANN	RAULAND	R4KANN	ANNUNCIATOR PANEL	SINGLE GANG BACKBOX W/ 1 GANG RING	OUTLET
NR	RAULAND	NCTVR1	TELEVISION INTERFACE MODULE	N/A LOCATED BEHIND PATIENT STATION	
SLC	RAULAND	R4KSLC1	LIGHT RELAY MODULE	N/A LOCATED BEHIND PATIENT STATION	
BED	RAULAND	NCBED	37 PIN BED RECEPTACLE	4 X 4 SQ. 2-1/8" DEEP 1 GANG RING	44" A.F.F.
BR	RAULAND	NCBRDY	BED MANAGEMENT STATION	4 X 4 SQ. 2-1/8" DEEP 1 GANG RING	44" A.F.F.
CC	RAULAND	NCBRDY	BED MANAGEMENT STATION	4 X 4 SQ. 2-1/8" DEEP 1 GANG RING	44" A.F.F.

NOT ALL SYMBOLS MAY BE USED.
CABLE LEGEND
 O = BELDEN CAT5 CABLE ORANGE
 G = BELDEN CAT5 CABLE GREEN
 Y = BELDEN CAT5 CABLE YELLOW
 # INDICATES L-NET ADDRESS

Sheet:
**SITE PLAN &
 SYMBOL LEGEND**


NC-0.01



4242 Delaware Street
Denver, CO 80216
PH:(303) 750-6500
FX:(303) 750-6400

www.beaconcom.com

Key Plan:

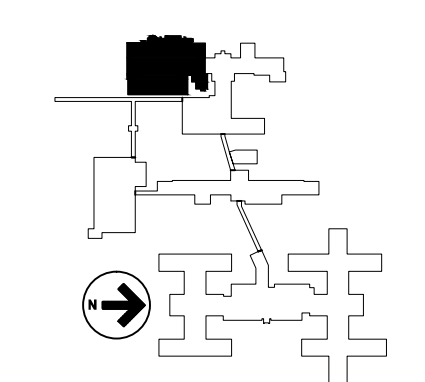

**VA BLACK HILLS
FORT MEADE CAMPUS
R4000 NURSE CALL SYSTEM
FORT MEADE, SD
NURSE CALL**

Job No.	130026
BY:	DATE:
Drawn: JZ	05-09-13
Checked:	-
Approved:	-
Original Issue:	-

ISSUE RECORD:		
No:	Date:	Description:
1	06-10-13	SUBMITTAL

Sheet:
BLDG 113 FLOOR 1
NURSE CALL -
SPECIALTY
& CLINICAL SCVS.
NC-1.00




S:\2013 Jobs\VA Fort Meade Cardiac Primary RT and Spec Care - 130026\Drawings\Beacon Drawings\NC-0.00 Cover and Floor Plans.dwg, 3/12/2014 11:21:44 PM, DWG To PDF.pc3



4242 Delaware Street
 Denver, CO 80216
 PH:(303) 750-6500
 FX:(303) 750-6400

www.beaconcom.com


Key Plan:

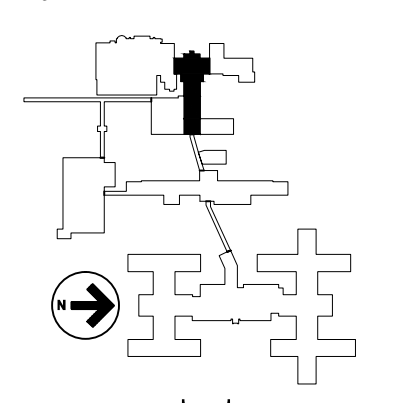

**VA BLACK HILLS
 FORT MEADE CAMPUS
 R4000 NURSE CALL SYSTEM
 FORT MEADE, SD
 NURSE CALL**

Job No.	130026
BY:	DATE:
Drawn: JZ	05-09-13
Checked:	-
Approved:	-
Original Issue:	-

ISSUE RECORD:		
No:	Date:	Description:
1	06-10-13	SUBMITTAL

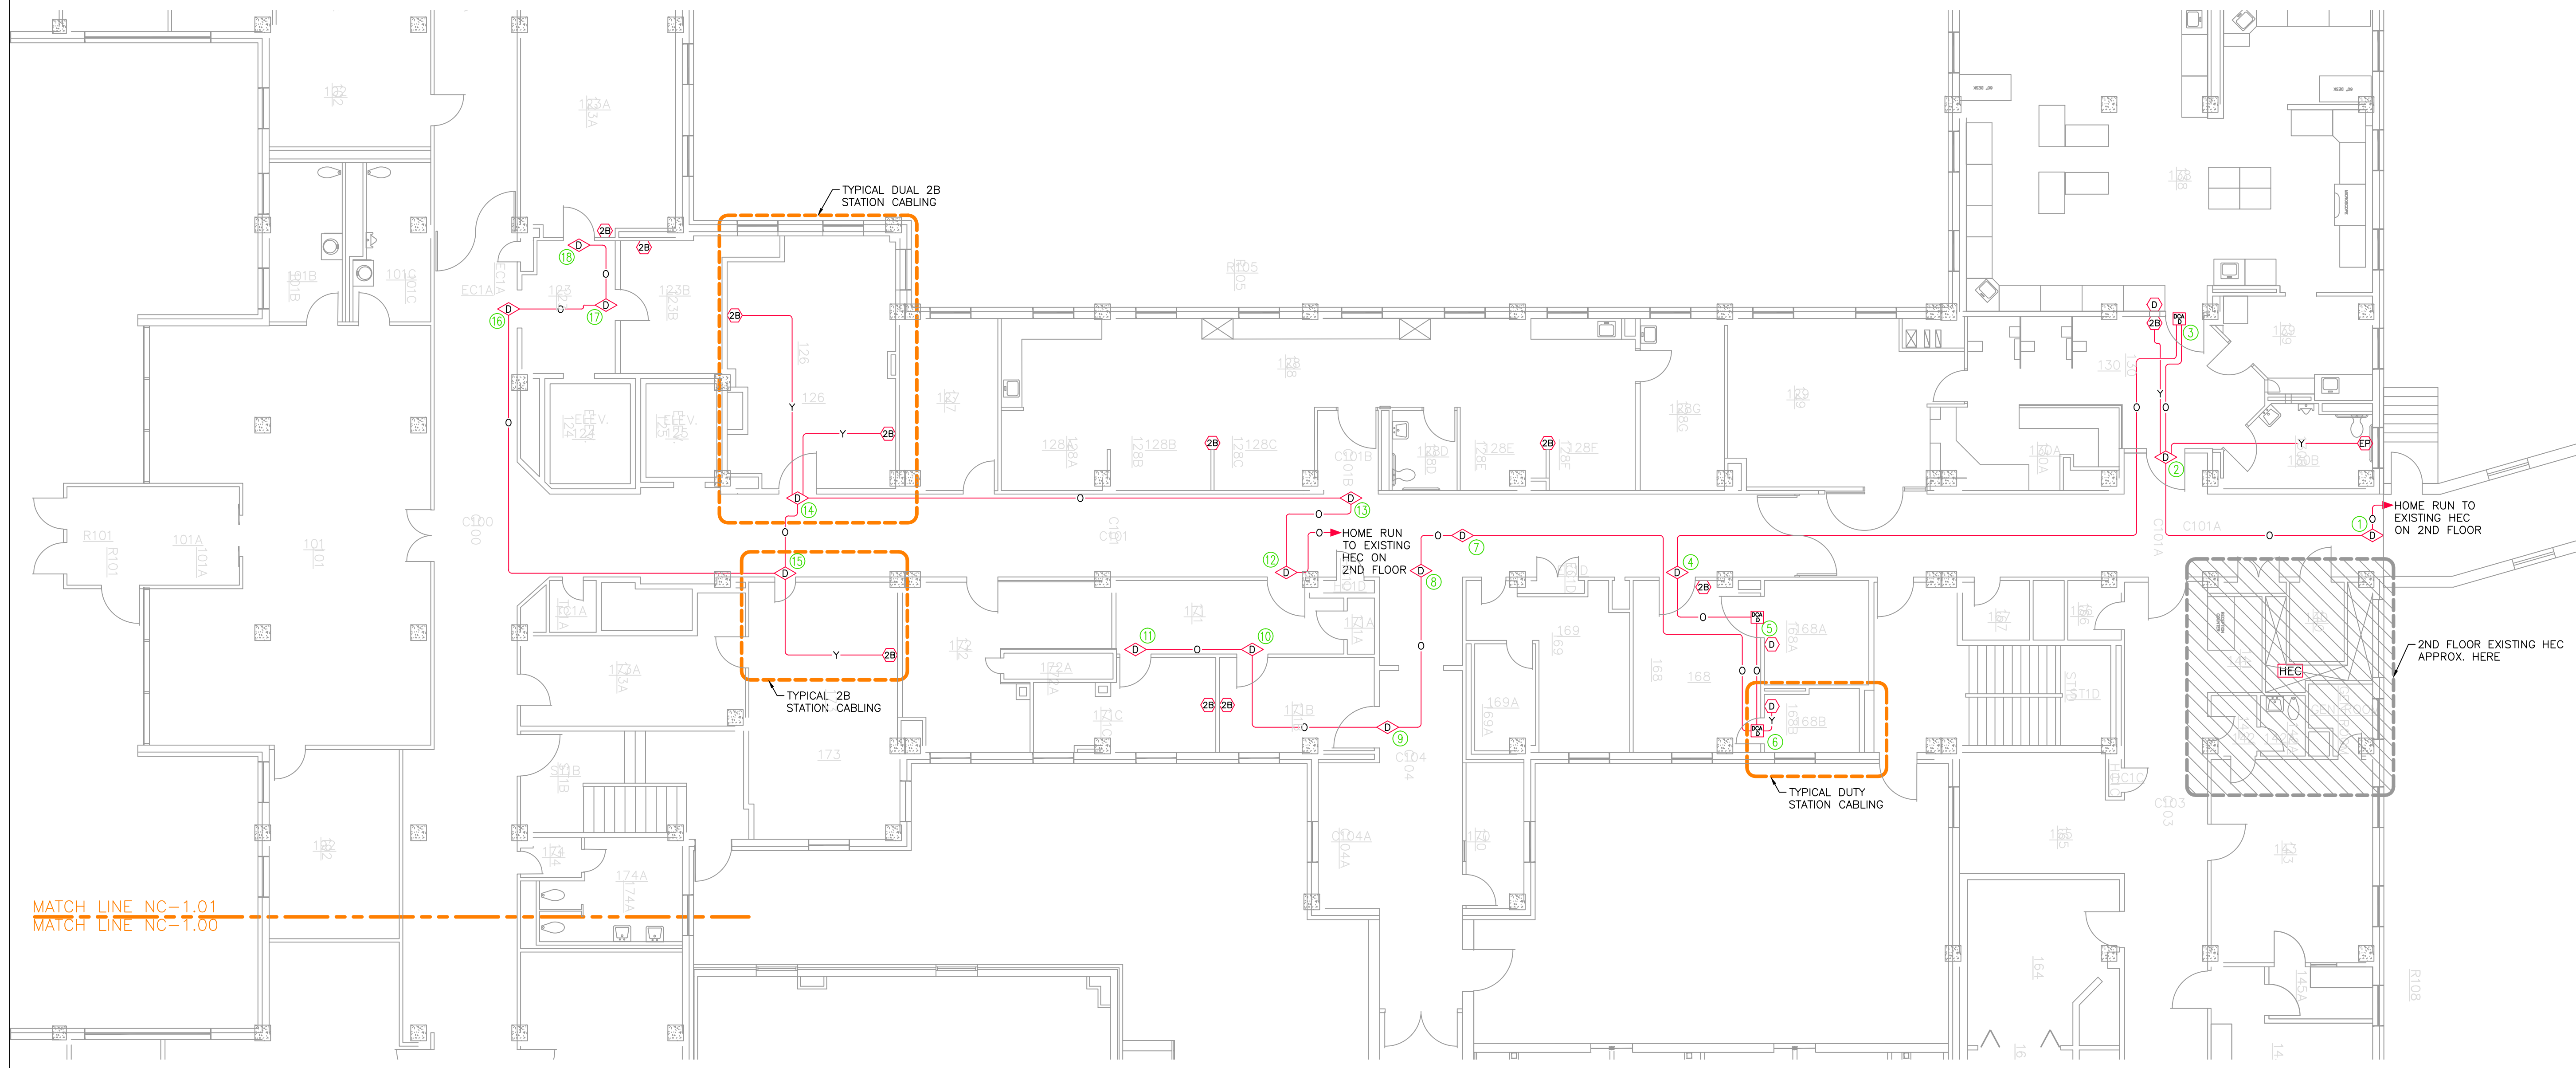

Sheet:
 BLDG 113 FLOOR 1
 NURSE CALL -
 RESPIRATORY
 THERAPY
NC-1.01


S:\2013 Jobs\VA Fort Meade Cardiac Primary RT and Spec Care - 130026\Drawings\Beacon Drawings\NC-0.00 Cover and Floor Plans.dwg, 3/12/2014 11:21:53 PM, DWG To PDF.pc3



4242 Delaware Street
 Denver, CO 80216
 PH:(303) 750-6500
 FX:(303) 750-6400

www.beaconcom.com

Key Plan:

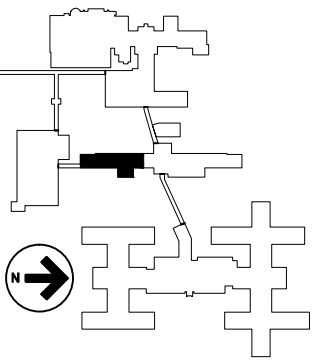


**VA BLACK HILLS
 FORT MEADE CAMPUS
 R4000 NURSE CALL SYSTEM
 FORT MEADE, SD
 NURSE CALL**

Job No. 130026

BY: DATE:
 Drawn: JZ 05-09-13
 Checked: - -
 Approved: - -
 Original Issue: - -

ISSUE RECORD:		
No:	Date:	Description:
1	06-10-13	SUBMITTAL

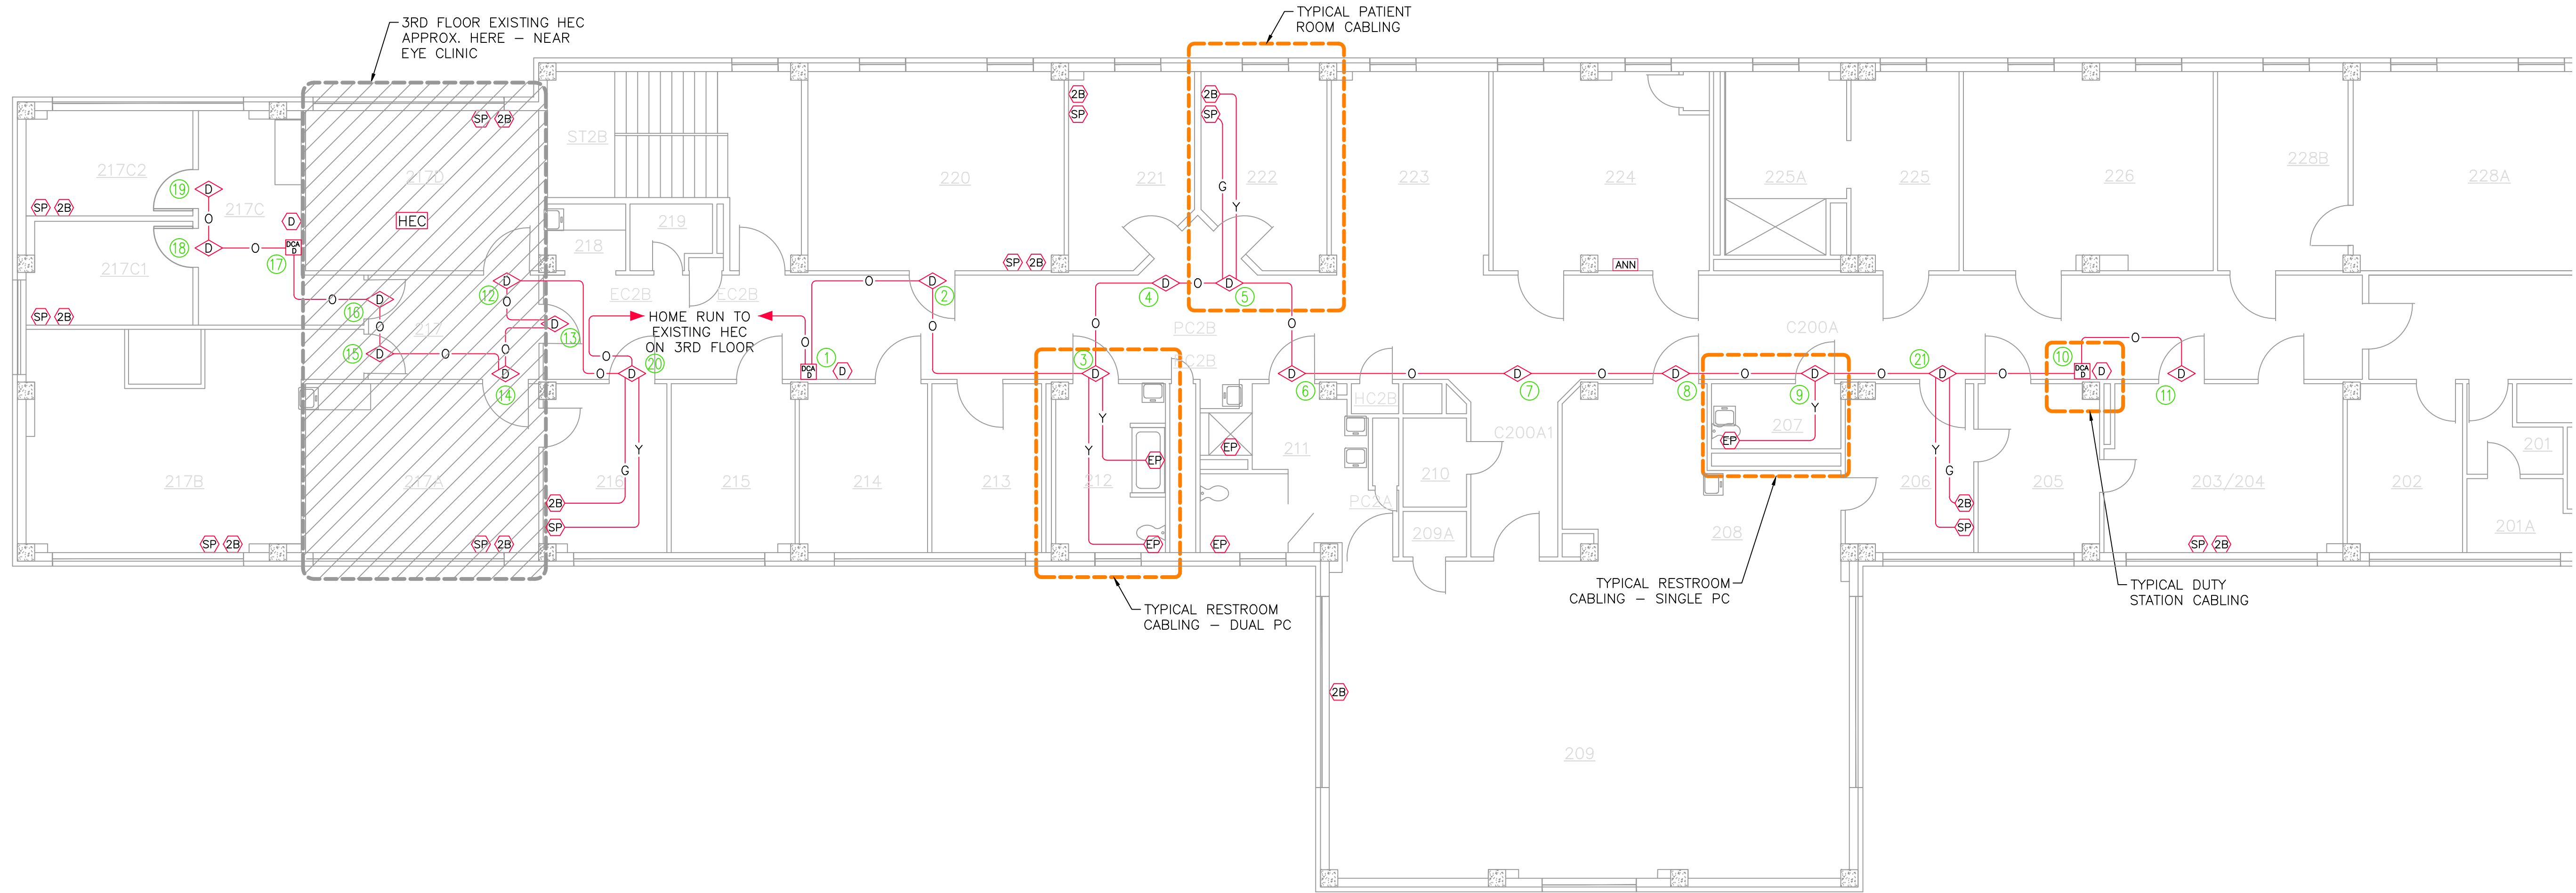

Sheet:
 BLDG 145 FLOOR 2
 NURSE CALL -
 CARDIAC SERVICES

NC-1.02


S:\2013 Jobs\VA Fort Meade Cardiac Primary RT and Spec Care - 130026\Drawings\Beacon Drawings\NC-0.00 Cover and Floor Plans.dwg, 3/12/2014 11:22:02 PM, DWG To PDF.pc3



4242 Delaware Street
 Denver, CO 80216
 PH:(303) 750-6500
 FX:(303) 750-6400

www.beaconcom.com

Key Plan:

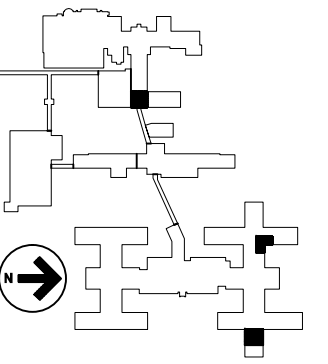



**VA BLACK HILLS
 FORT MEADE CAMPUS
 R4000 NURSE CALL SYSTEM
 FORT MEADE, SD
 NURSE CALL**

Job No. 130026



BY: DATE:
 Drawn: JZ 05-09-13
 Checked: - -
 Approved: - -
 Original Issue: - -

ISSUE RECORD:		
No:	Date:	Description:
1	06-10-13	SUBMITTAL



Key Plan:

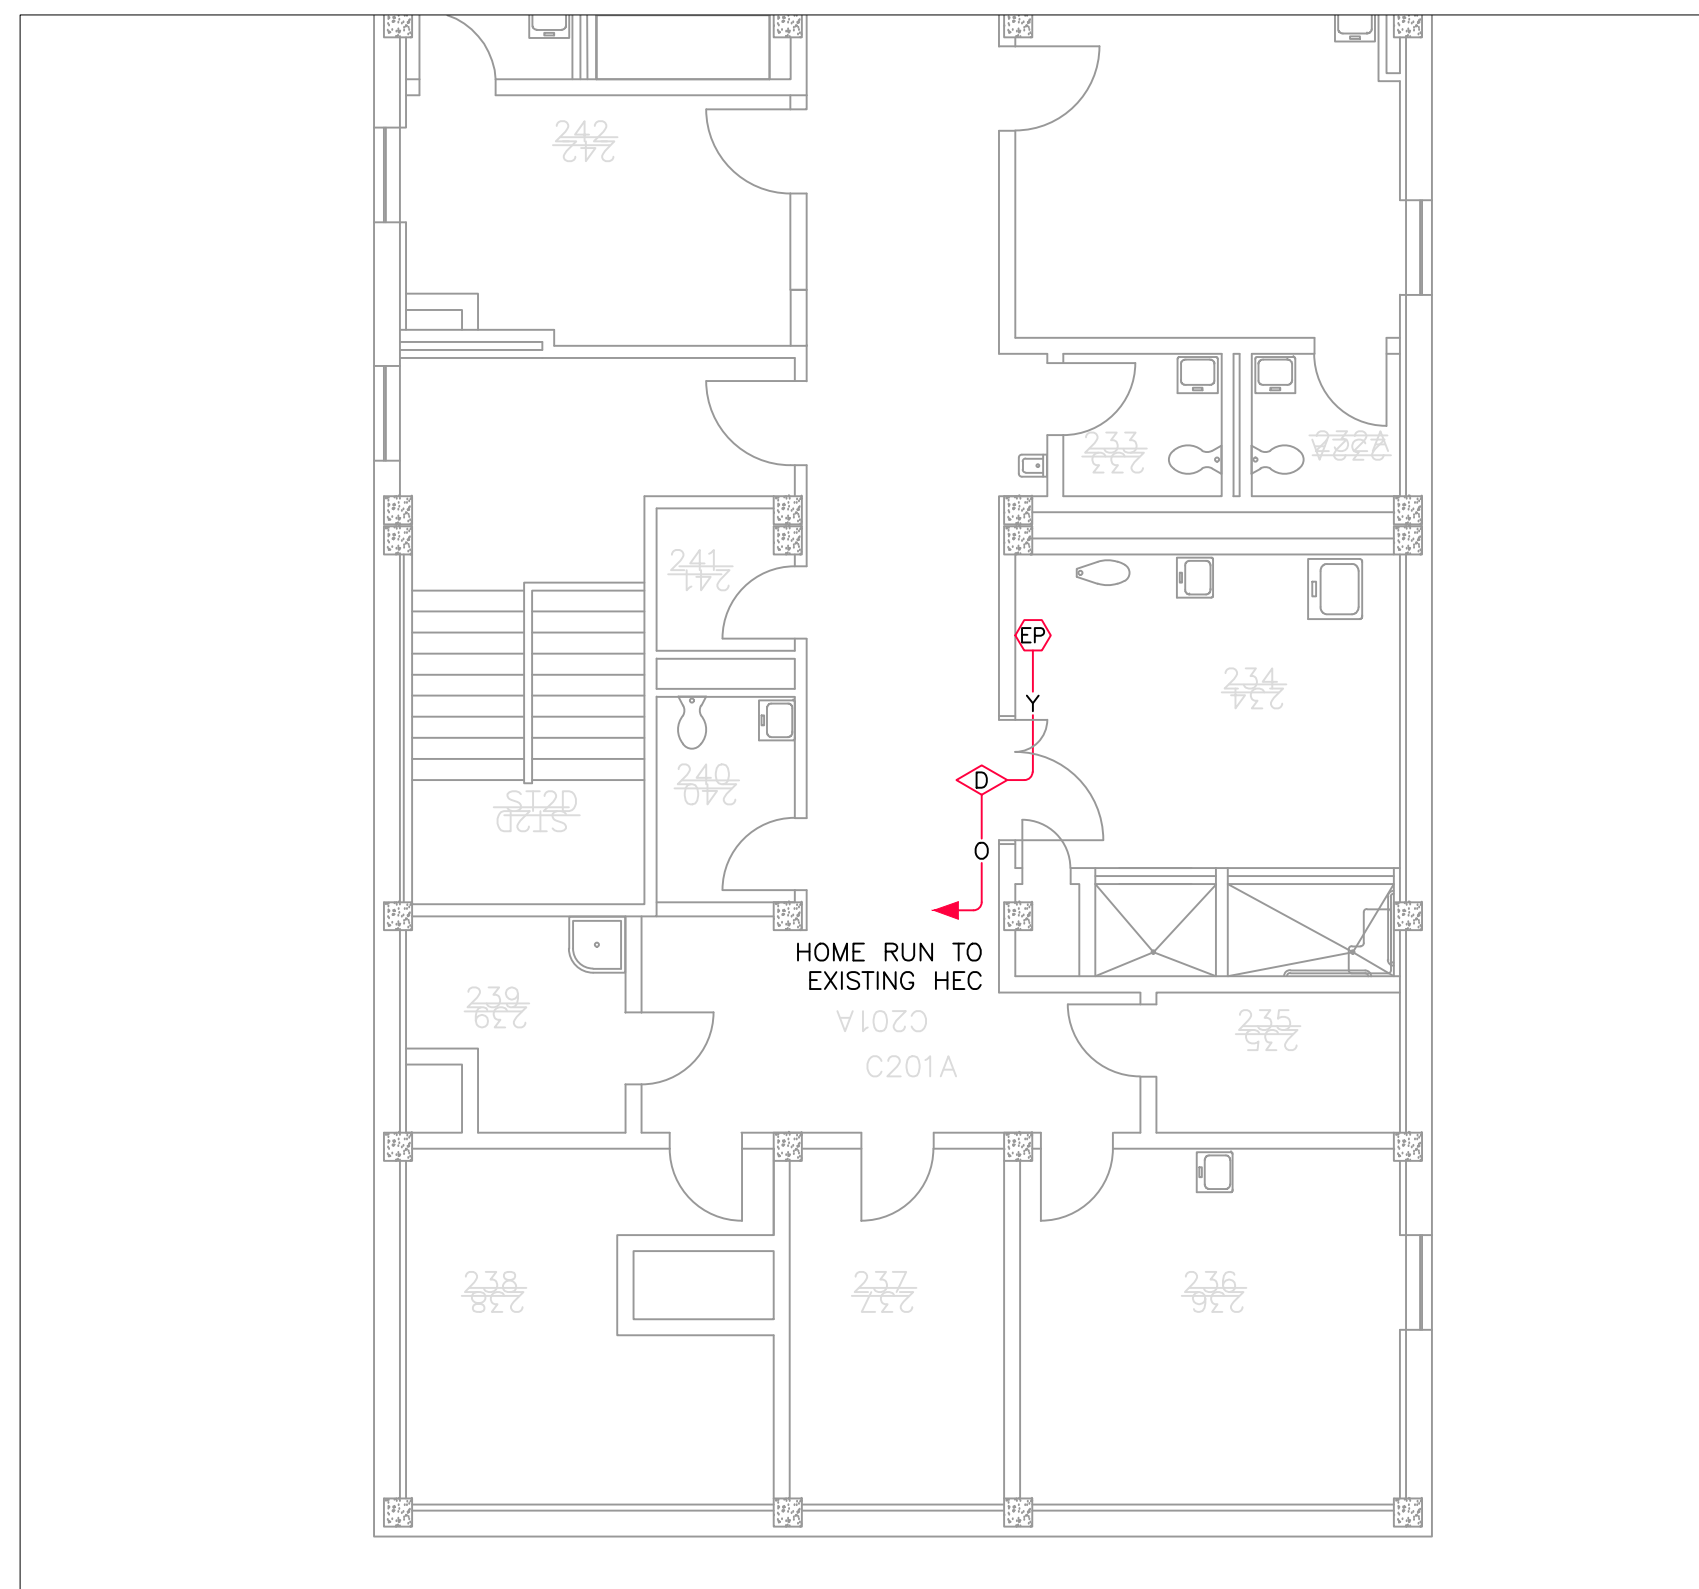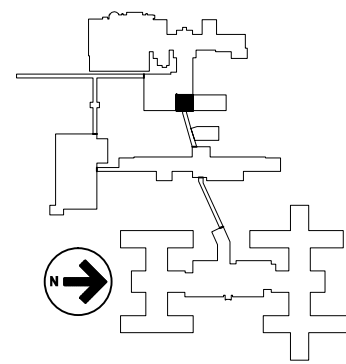

Key Plan:

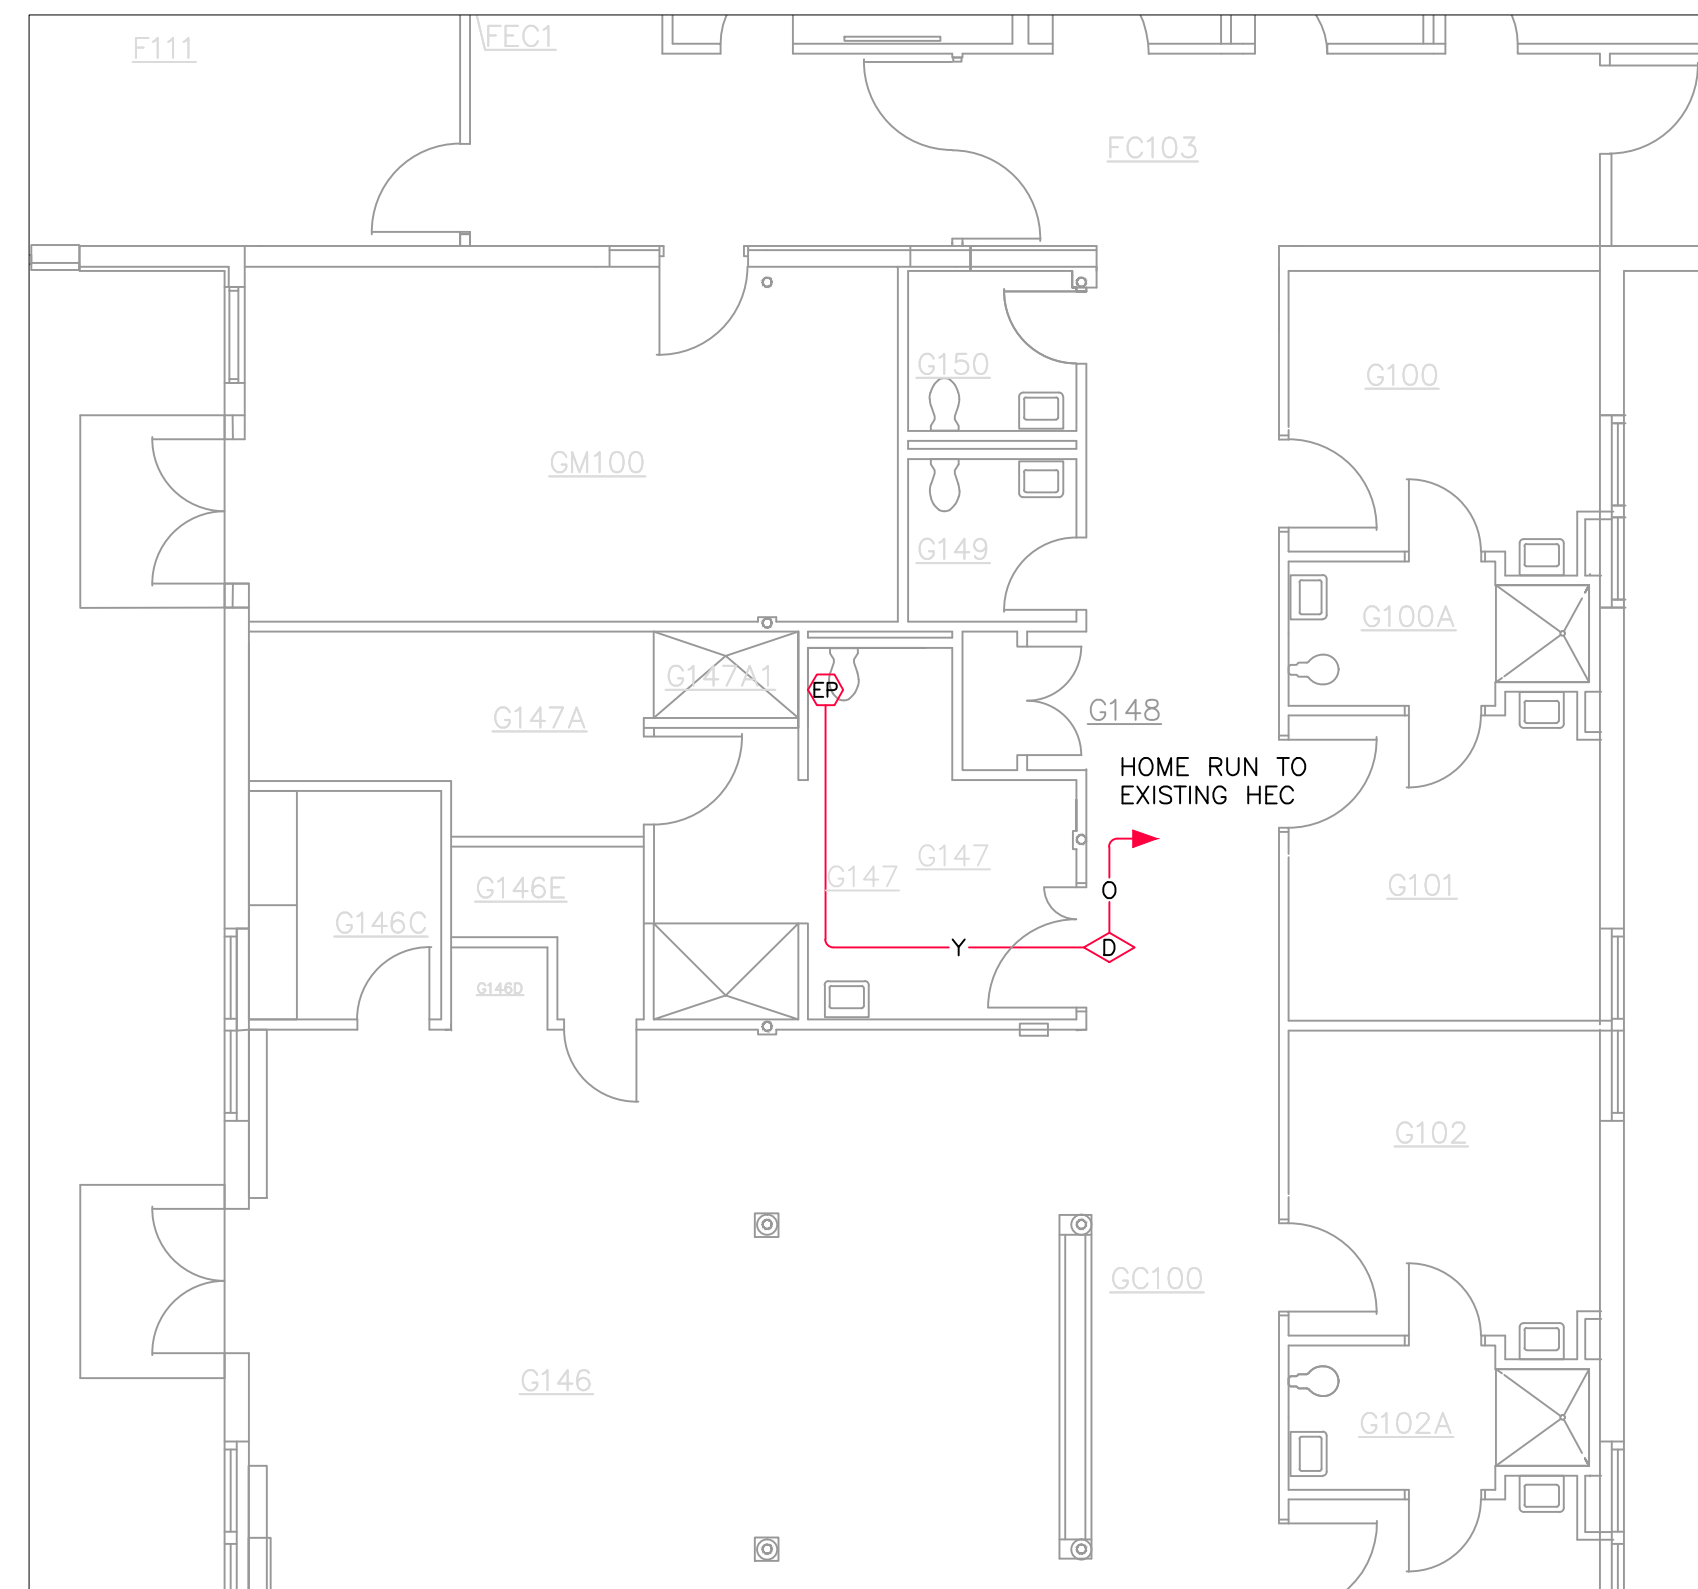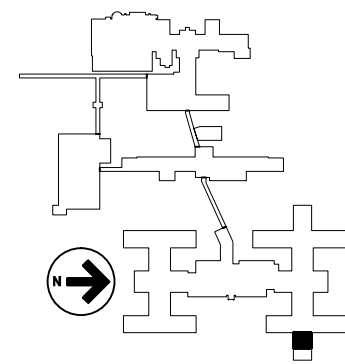

Key Plan:

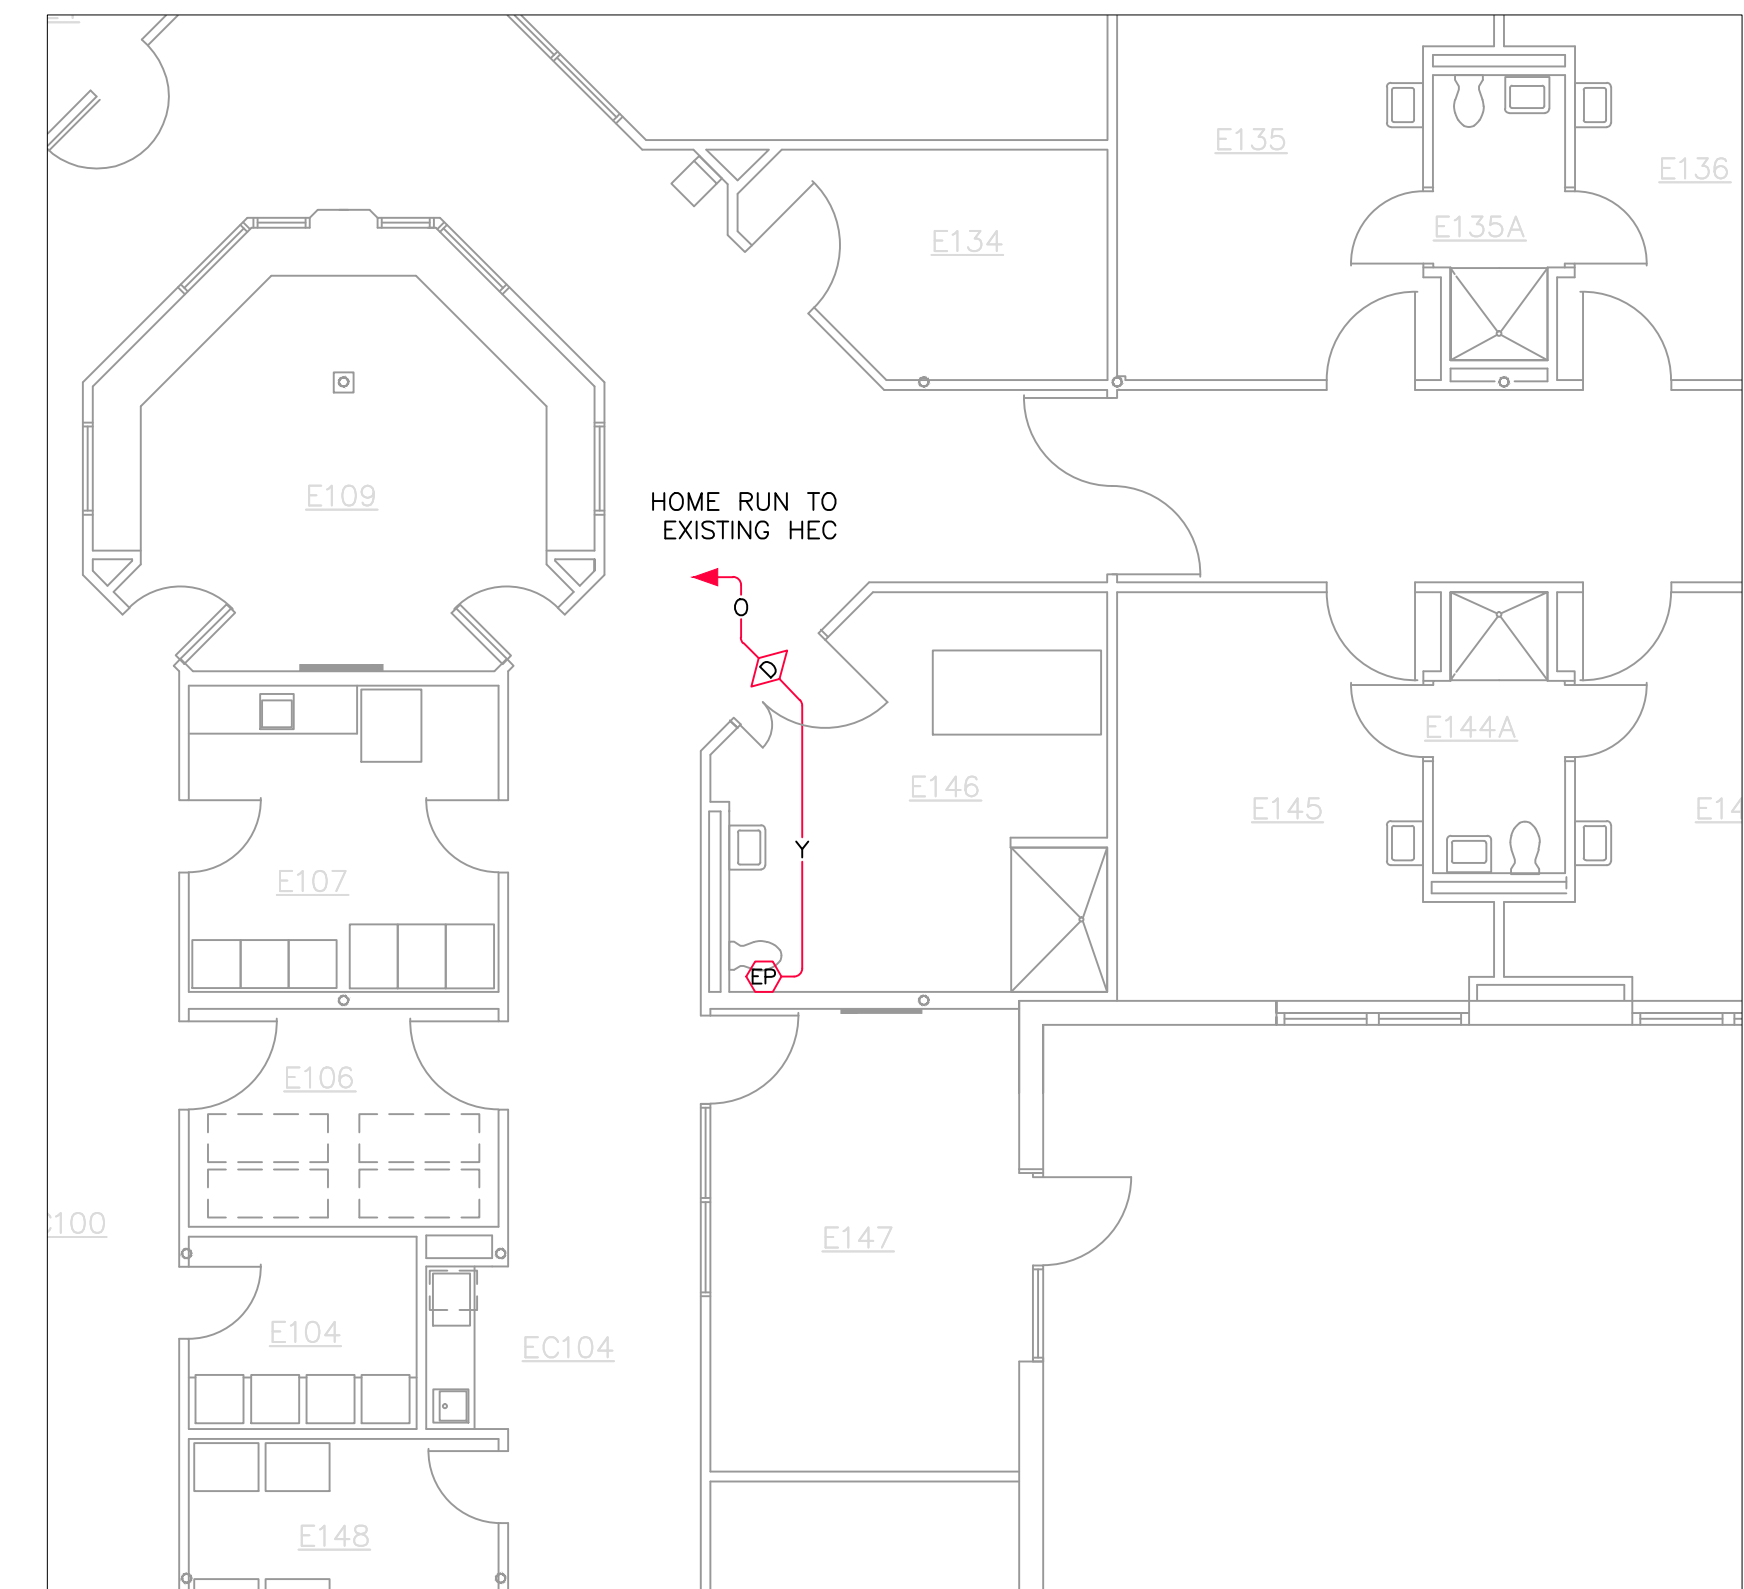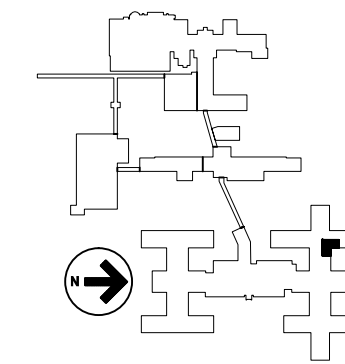

Sheet:
 BLDGS 148 & 113
 ROOM G147
 ROOM E146
 ROOM G234
NC-1.03